

WATER SERVICE RECORD

Name Joseph E. Chisholm

Service No. 212

Address 7 BRIDGE ST

4664

Location

Repair—Renewal—New Service

Can on 12-15-58


Date	Material	Amount	Total	Date	Amount	
10/15/58	Labor	5 55		11-14-58	Deposit	100 00
	10% overhead	56	6 11	12-15-58	Retard	61 28
	46' - 3/4" Copper tubing @ .37		17 02			38 72
	1 - 3/4" Cx 1/2 I.W.H. Stop & Waste		5 84		NON CHARGE	
	1 hr. Trucking		75		Labor	17 52
	1 hr. Trucking		3 00		9' - 3/4" Copper tubing @ .37	3 33
	1 hr. Rodgers Trailer		3 00		1 - 3/4" C. Corp Cock	4 64
	3x3 Patch		3 00		1 - 3/4" C. Curb Cock	6 03
			38 72		1 Box & Rod	5 00
					1 - 1/2 Straight tailpiece	50
					1 - 1/2 Offset tailpiece	50
					1 hr. Town Shovel	6 50
						44 02

DATE _____

TOWN OF LEXINGTON — BOARD OF PUBLIC WORKS

WATER DIVISION

Sketch of Service Here

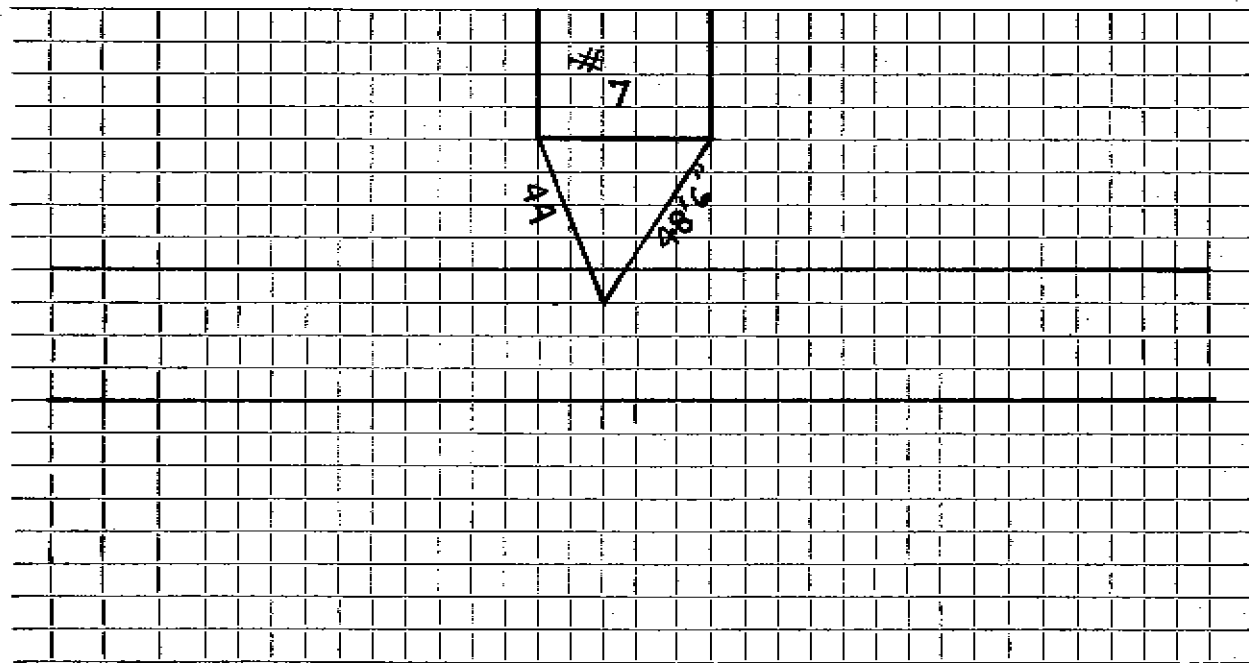

Connection made in Street. Work completed


Remarks:
.....
.....

DATE 7-15-1999

TOWN OF LEXINGTON — BOARD OF PUBLIC WORKS

WATER DIVISION

Sketch of Service Here

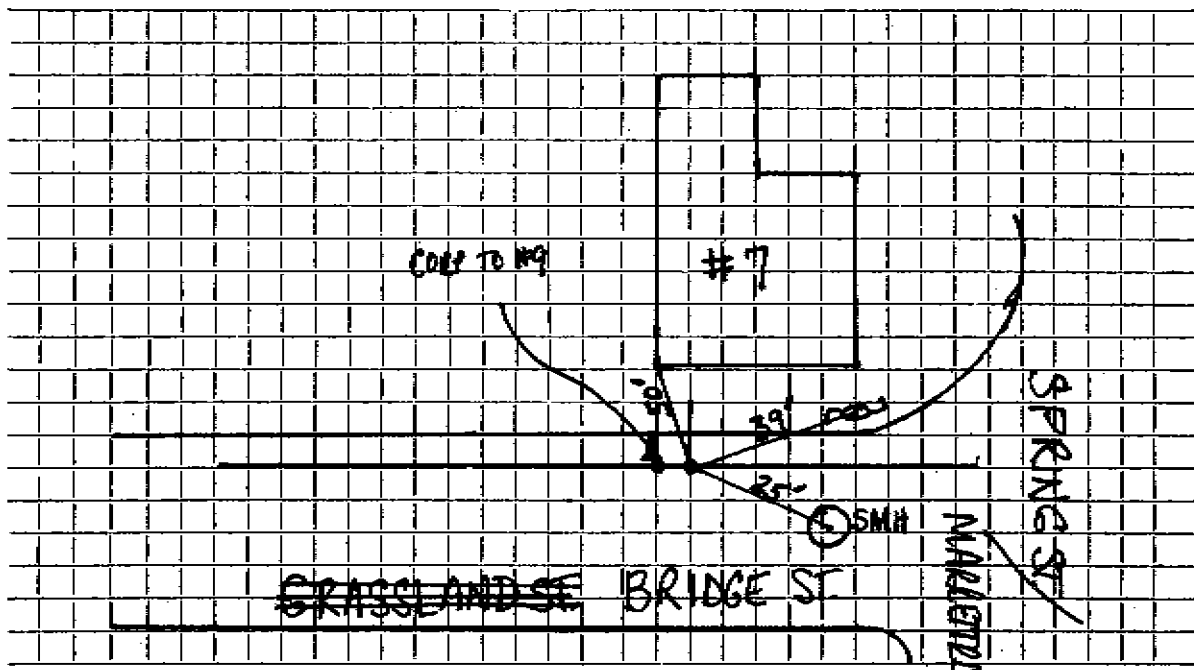

Connection made in 8" MAIN in GRASSLAND SE Street. Work completed NEW CORPORATIONS, UNION

Remarks: #7 & #9 CORPORATIONS ARE ~2' APART FROM EACH OTHER OFF 8" MAIN.