

WATER SERVICE RECORD

Name **Bernard Maloney**

Service No. **87**

Address **71 Bridge Street**

Location

Repair—Renewal—New Service **W.D.#3164**
Valeri #A472

Sep 5 1967

Date		Material	Amount	Total	Date	Amount
11/15/66	39'	3/4" Copper tubing			11-9-67	100 00
11-9-66		Labor	31.02		9-5-67	22 37
		10% O.H.	3.10	34.12		77 63
	1	Corp Cock		7.42		
	1	Curb Cock		8.76		
	1	Box & Rod		5.10		
	12'	3/4" Copper tubing @.79		9.48		
	1 1/2 hr	Shovel @6.50		9.75		
	1	hr. Trucking @3.00		3.00		
				<u>77.63</u>		


Deposit
Refund

DATE _____

TOWN OF LEXINGTON — BOARD OF PUBLIC WORKS

WATER DIVISION

Sketch of Service Here

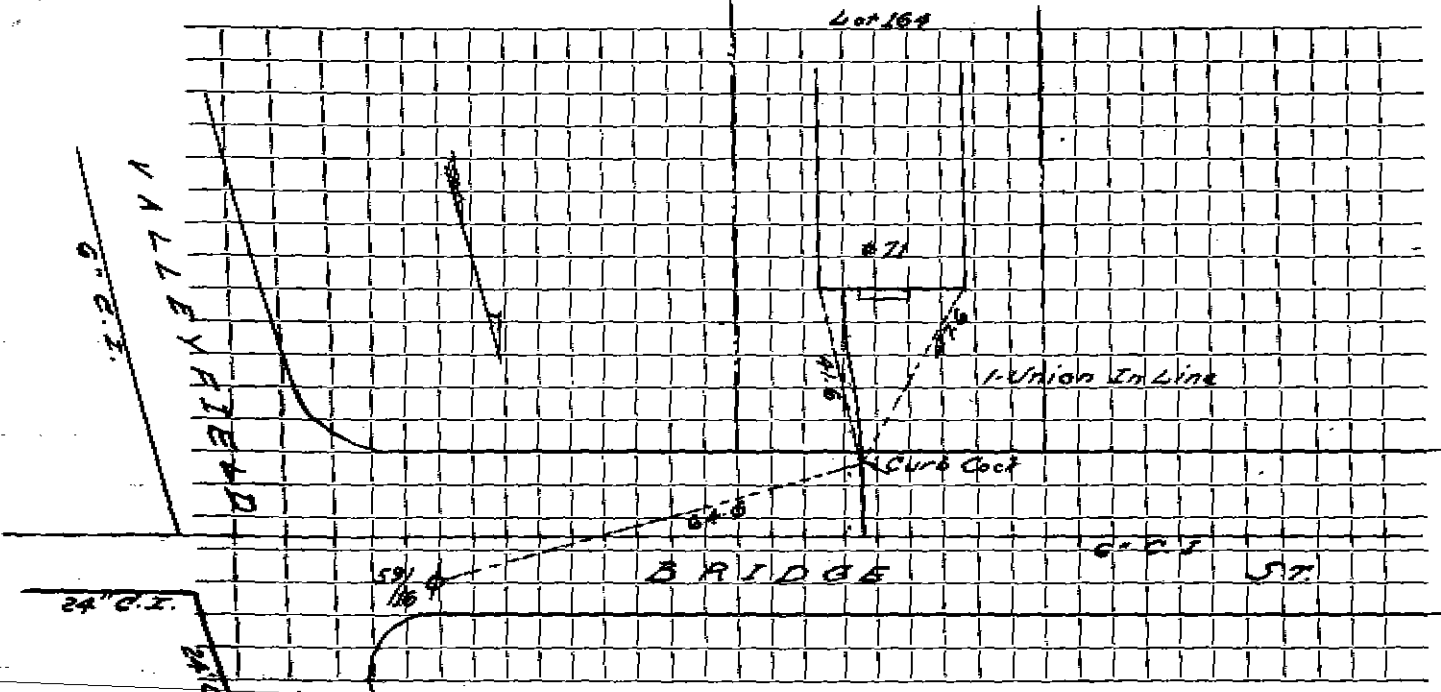

Connection made in _____ Street. Work completed _____

Remarks: _____

