

WATER SERVICE RECORD

Name Stratvern Realty Inc.

Service No. 44

Address 80 Bridge Street

Location

Repair—Renewal—New Service Kirkland #717 No# 5179

MAR 18 1968


Date		Material	Amount		Total	Date		Amount	
8-16-67	35'	3/4" Copper tubing				9-25-67	<i>Deposit</i>	100	00
						3-18-68	<i>Paid by WHTA 67</i>	18	34
7/27/67		Labor	56	24		4-4-68	<i>Paid</i>	2	40
		10% O.H.	5	62	61			120	74
	30'	3/4" copper pipe @ .79			23				
	1	3/4" corp.			7				
	1	3/4" curb cock			8				
	2	hrs. trucking @ 3.00			6				
	2	hr. shovel @ 6.50			13				
					120	74			
								<i>Bill sent 2/28</i>	

DATE _____

TOWN OF LEXINGTON — BOARD OF PUBLIC WORKS

WATER DIVISION

Sketch of Service Here

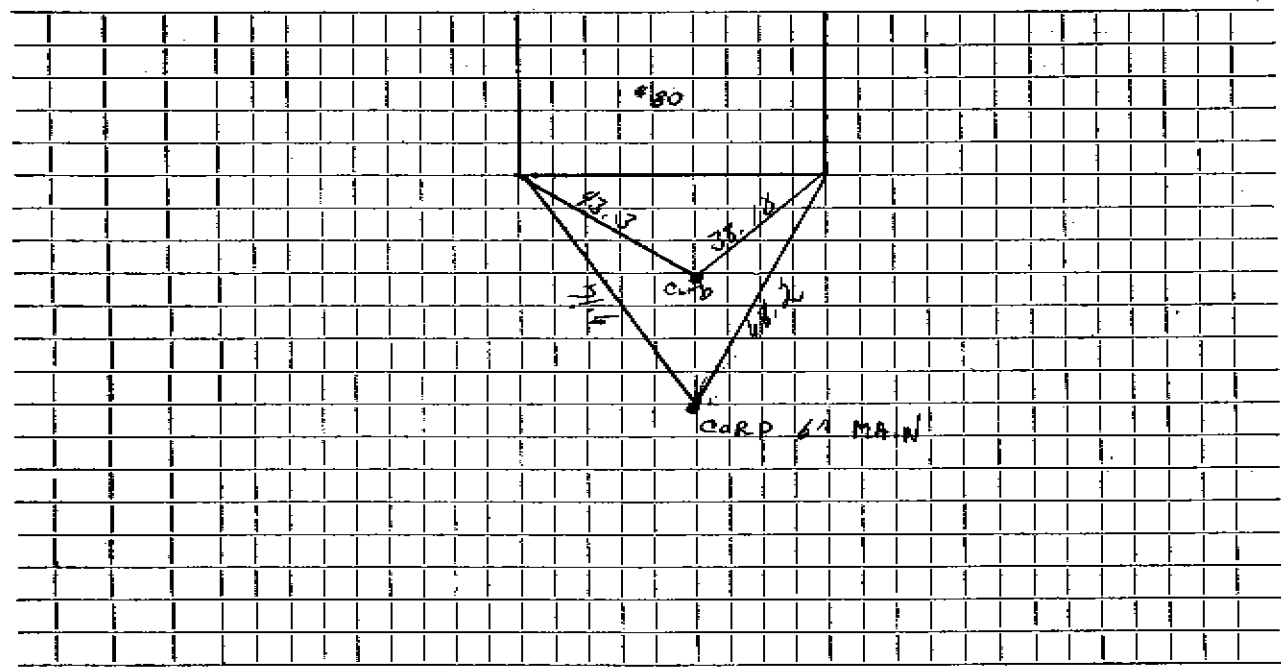

Connection made in Street. Work completed

Remarks:
.....
.....