

WATER SERVICE RECORD

Name Stratvern Realty Inc.

Service No. 45

Address 84 Bridge Street

Location

Repair—Renewal—New Service Kirkland #718 *W.D.#5180*


MAR 18 1968

Date	Material	Amount	Total	Date	Amount
8-16-67	35' 3/4" Copper tubing			7-27-68	100 00
				8-11-68	45 69
7/27/67	Labor 55.44	55 44			145 69
	10% O.H.	5 54	60 98		
	30' 3/4" copper pipe @ .79		23 70		
	1 3/4" corp.		7 42		
	1 3/4" curb cock		8 76		
	box & rod		5 10		
	21,000 lbs. 3/4" stone		17 23		
	1 hr. trucking @ 3.00		3 00		
	3 hr. shovel @ 6.50		19 50		
			145 69		

DATE _____

TOWN OF LEXINGTON — BOARD OF PUBLIC WORKS
WATER DIVISION

Sketch of Service Here

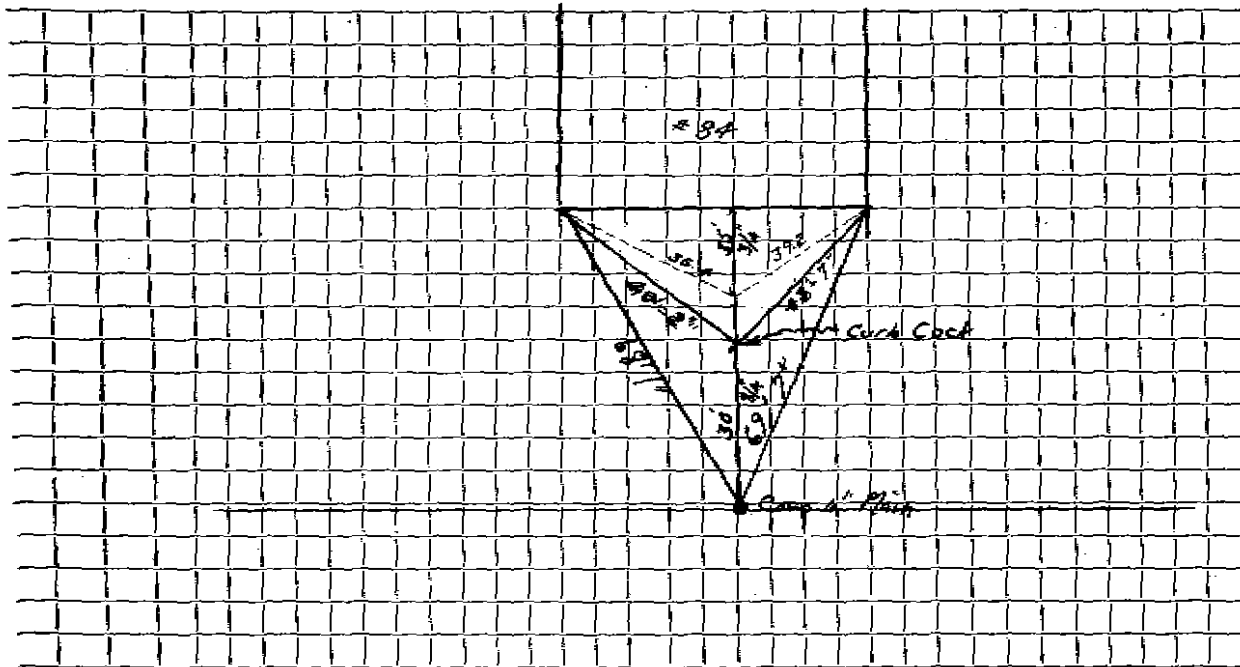

Connection made in Street. Work completed

Remarks:
.....
.....