

WATER SERVICE RECORD

5321

Name R. D. Hamilton Construction Co

Service No. 76

Address 85 Bridge Street

Location

~~Repair/ Renewal~~ - New Service *20 Valves # 919*

AUG 5 1968


Date	Material	Amount	Total	Date	Amount
12/11/67	Labor	43 35		11-1-67	125 00
	10% O.H.	4 33	47 68	8-5-68	36 42
	14' 3/4" copperpipe @ .79		11 06		98 58
	1 3/4" curb cock		11 32		
	1 box and rod		5 10		
	1 hr. trucking		3 00		
	2 hrs. shovel @ 6.50		13 00		
	1 3/4 corporation		7 42		
		TOTAL COST	98 58		
12-20-67	42' 3/4" Copper tubing				

TOWN OF LEXINGTON — BOARD OF PUBLIC WORKS

WATER DIVISION

DATE _____

Sketch of Service Here

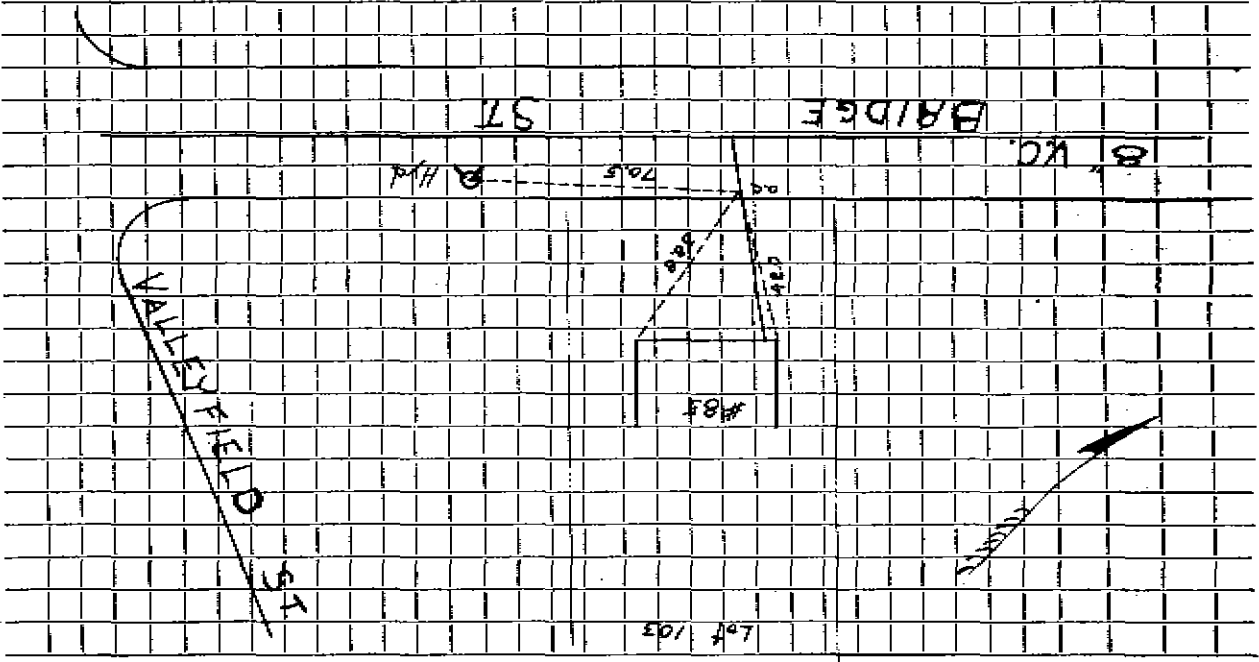

Street. _____
Work completed _____

Connection made in _____

Remarks: _____

