

WATER SERVICE RECORD

3688

Name Joseph E. Chisholm

Service No. 213

Address 9 BRIDGE ST

Location

Repair—Renewal—New Service

Comm 12-15-58


Date	Material	Amount	Total	Date	Amount
10/15/58	Labor	5 55		10-14-58	100 00
	10% overhead	56	6 11	12-15-58	62 84
	58' - 3/4" Copper tubing @ .37		21 46		37 16
	1' - 3/4" Cx 1/2 I.W.H. Stop & Waste		5 84		NON CHARGE
	1 hr. Trucking		75	Labor	22 64
	3x3 patch		3 00	9' - 3/4" Copper tubing @ .37	3 33
			37 16	1 - 3/4" C. Corp Cock	4 64
				1 - 3/4" C Curb Cock	6 03
				1 Box & Rod	5 00
				1 - 1/2 straight tailpiece	50
				1 - 1/2 Offset tailpiece	50
				1 hr. Town Shovel	6 50
					49 14

TOWN OF LEXINGTON — BOARD OF PUBLIC WORKS

WATER DIVISION

DATE _____

Sketch of Service Here

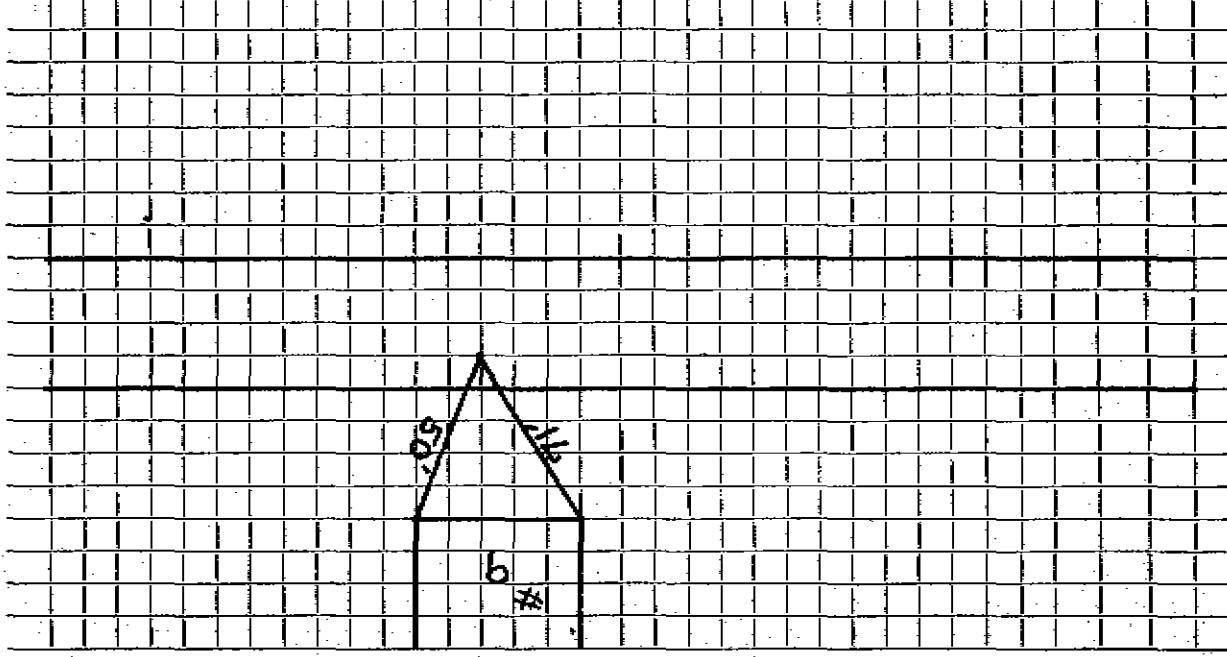

Street _____
Work completed _____

Connection made in _____


Remarks: _____

DATE 7-16-1999

TOWN OF LEXINGTON — BOARD OF PUBLIC WORKS

WATER DIVISION

Sketch of Service Here

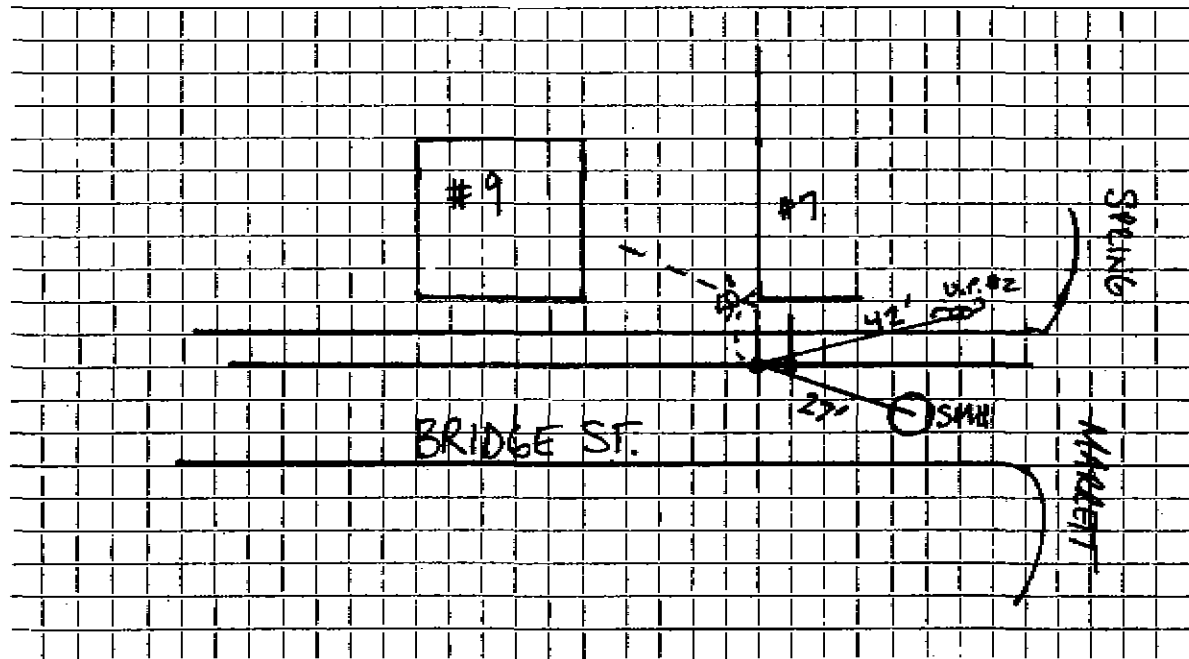

Connection made in 8" MAIN ON BRIDGE ST. Street. Work completed NEW CORPORATION, 1 UNION

Remarks: * SERVICE FOR #9 BRIDGE ST. IS LOCATED IN FRONT OF #7 BRIDGE. SERVICES FOR #9 & #7
ARE ~ 2' APART FROM EACH OTHER OFF 8" MAIN.