

**WATER SERVICE RECORD**

**Name** Stratvern Realty

**Service No.** 68

**Address** 91 Bridge Street

**Location**

**Repair—Renewal—New Service** W.O.#5550 Kirkland#812

**MAR 18 1968**

Date		Material	Amount		Total	Date	Amount
10-19-67	43'	3/4" Copper tubing				9-18-68	100 00
						8-5-68	15 78
							84 22
10/11/67		Labor	27	42			
		10% O.H.	2	74	30 16		
	18'	3/4" Copper tubing @	.79		14 22		
	1	3/4" Corporation			7 42		
	1	3/4" Curb Cock			11 32		
	1	Box & SHM Rod			5 10		
	1	Hr. Trucking			3 00		
	2	Hrs. Shovel @ 6.50			13 00		
					84 22		


*Deposit  
Retund*

DATE \_\_\_\_\_

# TOWN OF LEXINGTON — BOARD OF PUBLIC WORKS

## WATER DIVISION

Sketch of Service Here

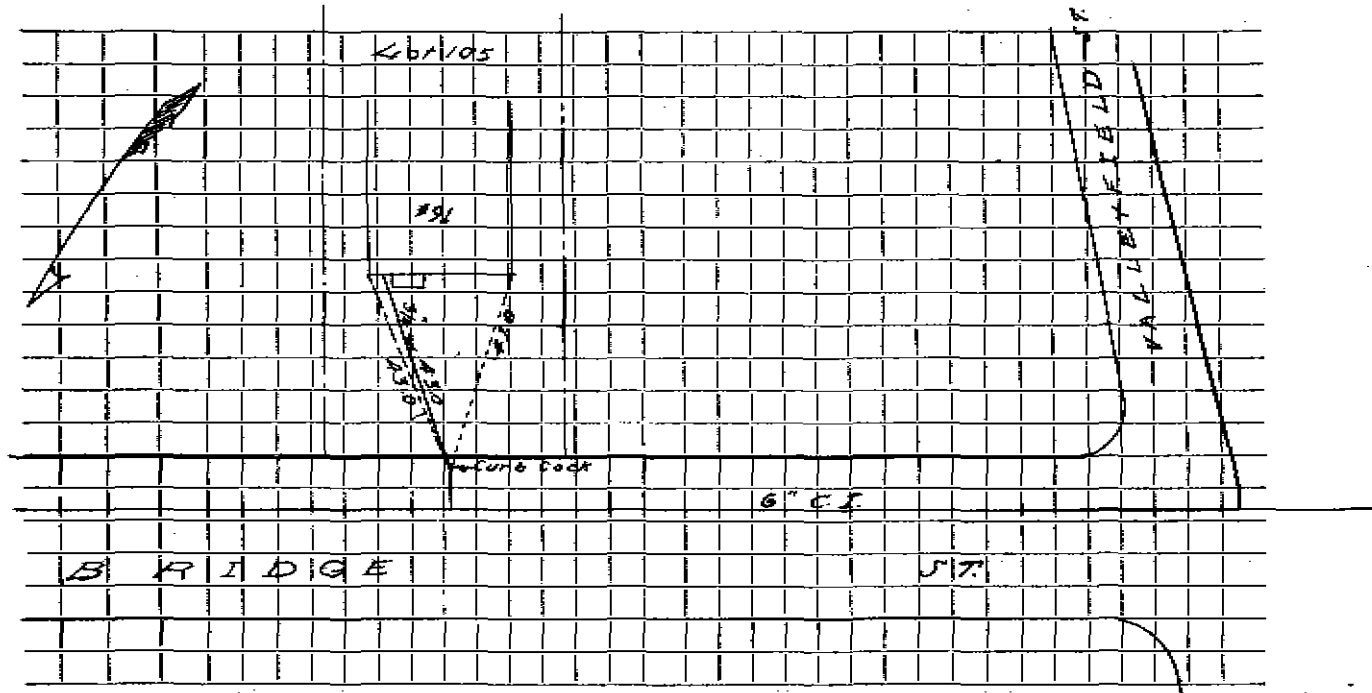

Connection made in ..... Street. Work completed .....

Remarks: .....  
.....  
.....