

Name Adolph Cuccinello
 Address 92 Bridge Street

Service No. 141
 #616

Location 92 Bridge Street

Kind of Pipe
 Size
 Size of Main
 Remarks: ~~Repair~~ - New Service Com. 9-19-49 Location

Date	Material	Amount	Total	Date	Location	Amount
July 22, '49	Labor	5 65	5 65	July 19, '49	Deposited	50 00
	10% Overhead		57	Sept 21, '49	6 Cured	8 56
	60' - 3/4" Copper Tubing @.24	14 40			Non-Charge	41 49
	1 - 3/4" C x 1/2" I.W.H. S&W	3 29		July 22, '49	Labor	5 00
	2 - 3/4" C x 3/4" C Unions @1.39	2 78			30' - 3/4" Copper Tubing @.24	7 20
	Littlefield Shovel 2 hrs. @7.00	14 00			1 - 3/4" C corp-cock	3 15
	Trucking 1 hr.		75		1 - 3/4" C x 3/4" C Curb-cock	3 85
			41 44		1 - Box & Rod	3 95
					2 - 1/2" Straight Tail Piece @.37	74
					Littlefield Shovel 1 hr.	7 00
					Trucking 1 hr.	75
	Labor					31 54

DATE _____

TOWN OF LEXINGTON - BOARD OF PUBLIC WORKS

48.8

WATER DIVISION

44.2

26.7

The undersigned applies for a supply of water at No..... St. and hereby agrees to comply with the rules and regulations as now, or at any future time, established by the Board of Selectmen.

Am't of Estimate \$.....


Owner

Am't Paid \$.....

Address

Builder

Sketch of Service Here

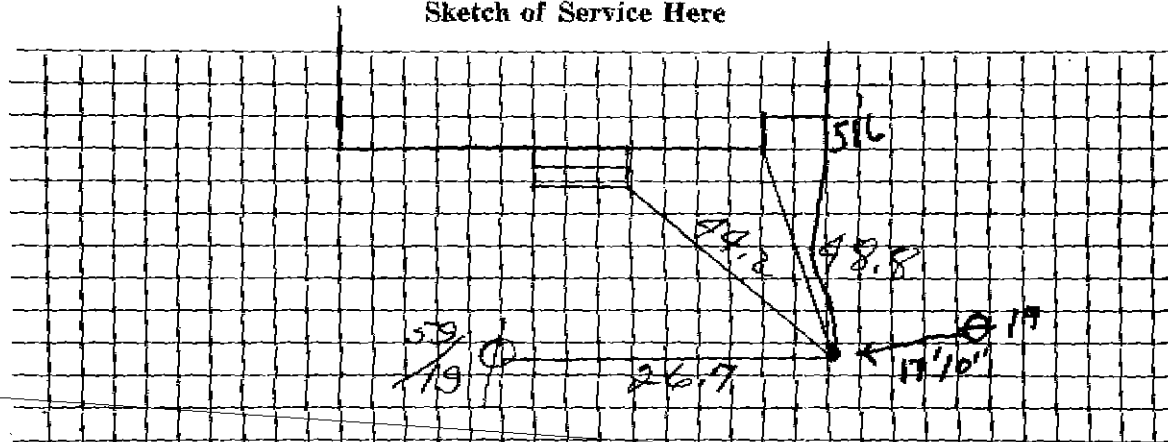

Connection made in Street.

Work completed19

Remarks: