

WATER SERVICE RECORD

Name Lauri A. Lindell

Service No. 82

Address 93 Bridge Street

Location

~~Repair~~ ~~Renovate~~ New Service 100# 3548


SEP 5 1967

Date		Material	Amount		Total	Date	Amount
11/9/66		Labor	24.	80		11-27-66	100 00
		10% O.H.	2.	48	27. 28	9-5-67	31 67
	1	Corp Cock			7. 42		68 33
	1	Curb Cock			8. 76		
	1	Box and Rod			5. 10		
	13	6" x 3/4" Copper Tubing			10. 27		
	1	Hr. Shovel @6.50			6. 50		
	1/2	Hr. Trucking			1. 50		
	1/2	Hr. Trucking			1. 50		
					68. 33		

DATE _____

TOWN OF LEXINGTON — BOARD OF PUBLIC WORKS
WATER DIVISION

Sketch of Service Here

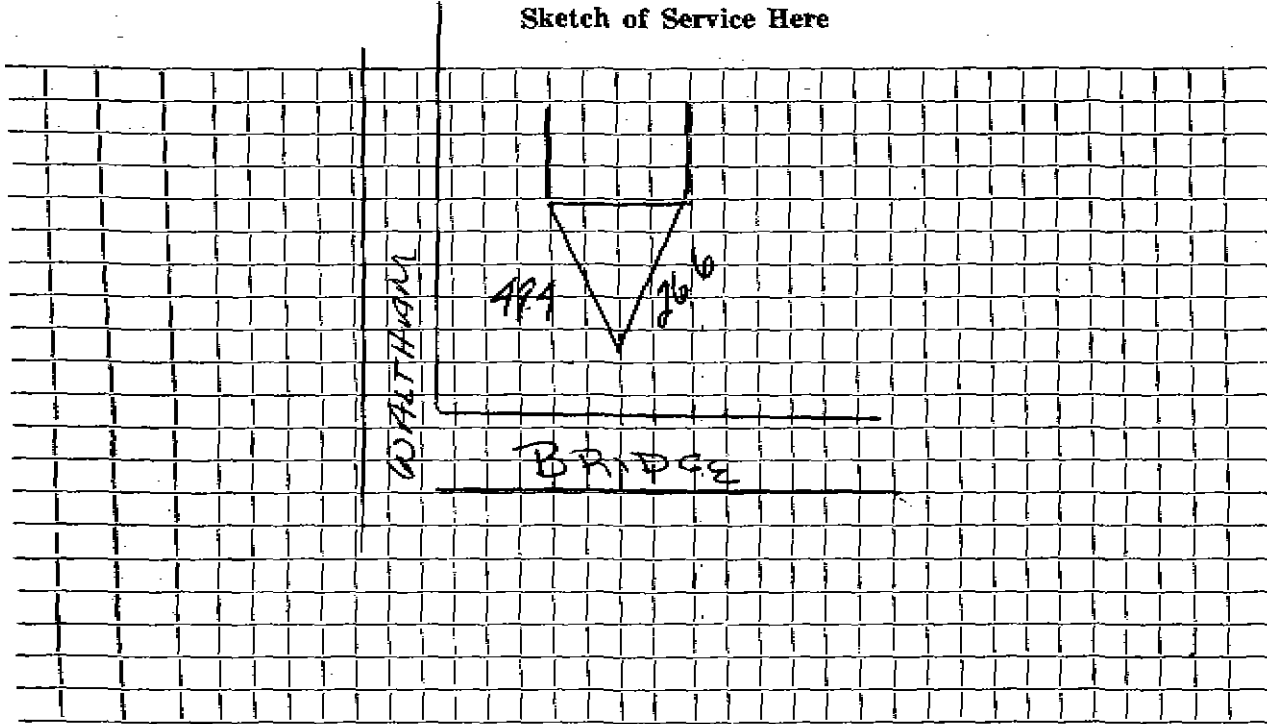

Connection made in Street. Work completed

Remarks:
.....
.....