

WATER SERVICE RECORD

Name Miller Zobel

Service No. 150

Address 16 Bridle Path

Location

~~Repair~~ - Renewal - ~~New Service~~


Cump 10-24-60

Date	Material	Amount	Total	Date	Amount
8-25-60	Labor	96.53		7-26-60	500.00
8-26-60	"	110.75		1-24-60	86.21
8-27-60	"	32.19	239.47		413.79
	10% O.H.	23.95	263.42		10% CHANGE
170	1" Copper tubing @ .4676		79.49	1	3/4" Offset tailpiece .70
1	1" x 1" Comp. Valve		6.96	1	3/4" Straight Tailpiece .70
4	1" 3 part unions @3.98		15.92		1.40
8	hrs. Pippin Shovel @4.50		36.00	10/15/48	Labor 1.15
4	hrs. Trucking @3.00		12.00	9'	1" Copper tubing @ .31 2.79
			413.79	1	1" C Corp Cock 3.96
				1	1" C x 1" C Curb Cock 4.80
					12.70

DATE _____

TOWN OF LEXINGTON — BOARD OF PUBLIC WORKS
WATER DIVISION

Sketch of Service Here

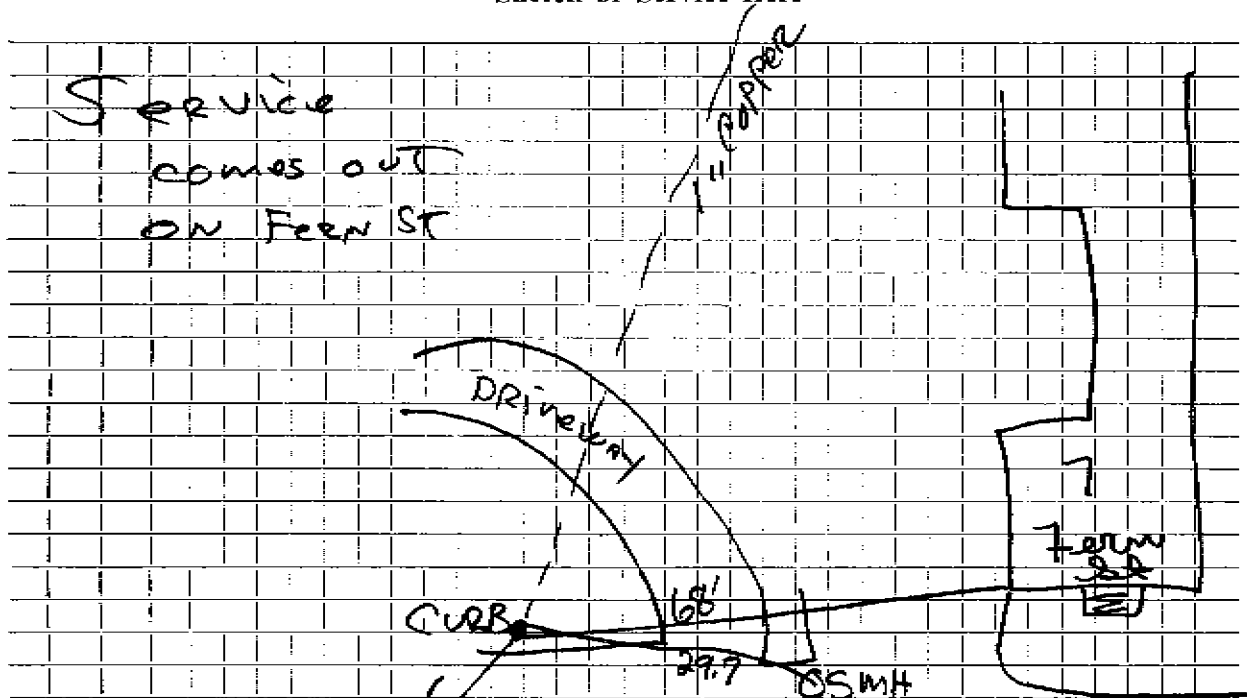

Connection made in Street. Work completed FERN ST

Remarks:

.....

.....