

Name Owen Lafley
 Address 18 Bridle Path
 Lexington, Mass.

Service No.

407

Location 18 Bridle Path

Kind of Pipe

Size

Size of Main

~~Repair~~—Renewal—~~New Service~~

Location

Date	Material	Amount	Total	Date	Amount	
Aug. 4, '47	Labor	19 72	19 72	Aug 2 49	60 00	
	10% Overhead		1 97	Sept 25 49	14 89	
	65' - 3/4" Copper Tubing @.28	18 20	18 20		45 11	
	2 - 3/4" C x 1" I.W.F. S & W	3 15	3 15	Aug. 4, '47	Labor	13 72
	1 - 3/4" C x 3/4" C Union (3pts)	1 32	1 32		15' - 3/4" Copper Tubing @.28	4 20
	Trucking 1 hr. @.75	.75	.75		1 - 3/4" C Corp-cock	3 00
			45 11		1 - 3/4" I x 1" I Turb-cock	3 68
					1 - 3/4" C x 3/4" I Union (2 pts)	87
					1 - 3/4" C x 1" I Union (2 pts)	87
					1 - Box & Rod	4 26
					1 - 3/8" Offset Tail Piece	30
					Trucking 1 hr. @.75	75
	Labor					31 65

Deposited
Refunded
 Non-Charge

TOWN OF LEXINGTON – BOARD OF PUBLIC WORKS
WATER DIVISION

The undersigned applies for a supply of water at No..... St. and hereby agrees to comply with the rules and regulations as now, or at any future time, established by the Board of Selectmen.

Am't of Estimate \$.....

Owner


Am't Paid \$.....

Address

Builder

.....

Sketch of Service Here

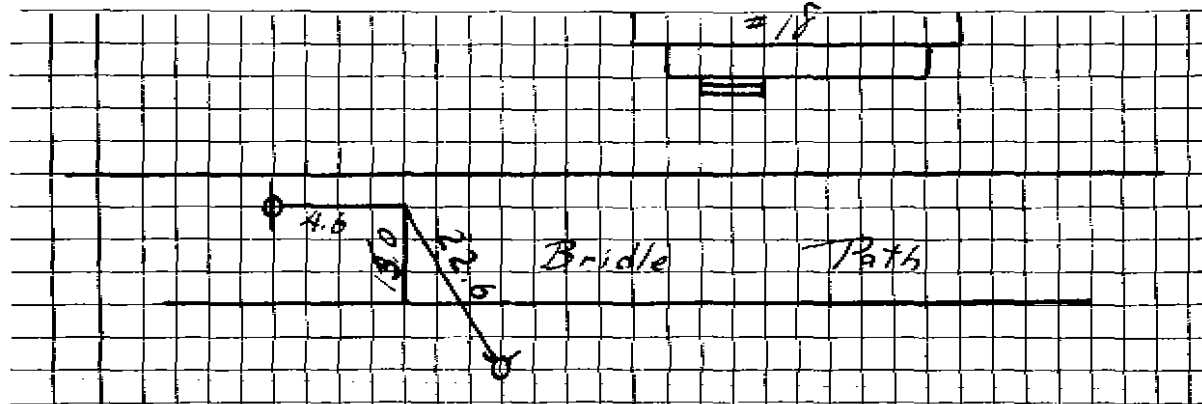

Connection made in

Street.

Work completed19

Remarks: