

Name Howard Baldwin

Service No. 137

Address 1 Briggs Road

Location 1 Briggs Road

Kind of Pipe

Size

Size of Main

~~Repair - Renewal~~ New Service

Com. 9-19-49

Location

Date	Material	Amount	Total	Date	Amount
Aug. 9, '49	Labor	8 10	8 10	Aug. 3, '49	75 00
	10% Overhead		81	Sept 20 49	14 80
	70' - 3/4" Copper Tubing @.24	16 80			60 44
	1 - 3/4" C x 1/2" I.W.H. S&W	3 29		Aug. 10, '49	4 90
	1 - 3/4" C x 3/4" C Union	1 39		18' - 3/4" Copper Tubing @.24	4 32
	Littlefield Shovel 2 hrs. @7.00	14 00		1 - 3/4" C Corp-cock	3 15
	Trucking 1 hr.		75	1 - 3/4" C x 3/4" C Curb-cock	3 85
	Patching 15 x 3		15 00	1 - Box & Rod	3 95
			60 14	1 - 1/2" Offset Tail Piece	37
				1 - 1/2" Straight Tail Piece	37
				Littlefield Shovel 2 hrs. @7.00	14 00
				Trucking 1 hr.	75
	Labor				35 66

TOWN OF LEXINGTON - BOARD OF PUBLIC WORKS

WATER DIVISION

The undersigned applies for a supply of water at No..... St. and hereby agrees to comply with the rules and regulations as now, or at any future time, established by the Board of Selectmen.

Am't of Estimate \$.....

Owner


Am't Paid \$.....

Address

Builder

.....

Sketch of Service Here

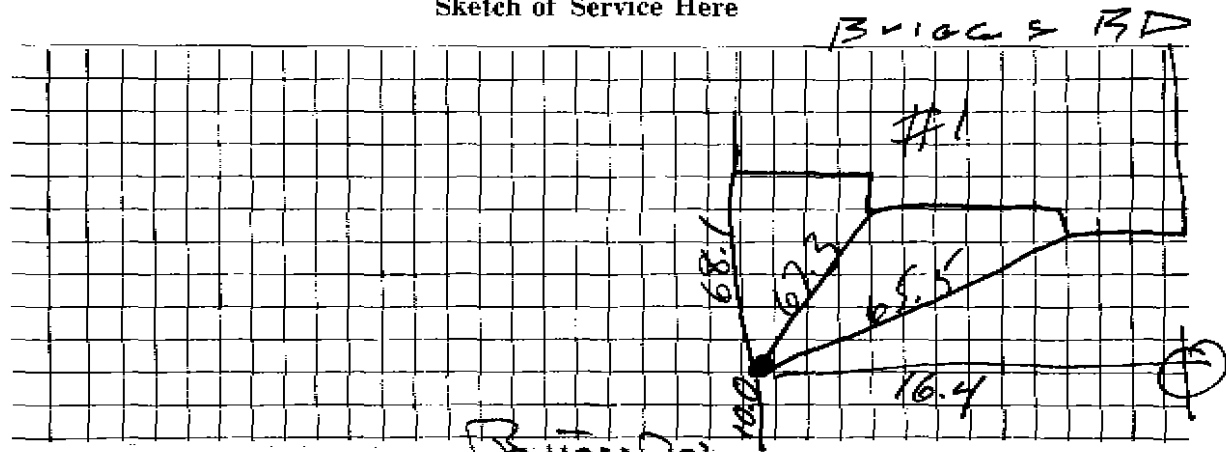

Connection made in Street.

Work completed19

Remarks: