

Name Gorham D. Stevens

Service No.

Address 10 Briggs Road
Lexington, Mass.

Location 10 Briggs Road

Kind of Pipe

Size

Size of Main

~~Repair - Renewal~~ - New Service

Com. 8-23-48

Location

Date	Material	Amount	Total	Date	Amount
Jul. 13, '48	Labor	3 25	3 25	July 9, '48	55 00
	10% Overhead		33	July 20, '48	6 28
	48' - 3/4" Copper Tubing @ .255	12 24			48 72
	1 - 3/4" C x 1/2" I.P.H. S & W	3 15		Non-Charge	
	Littlefield Shovel 2 hrs. @ 7.00	14 00		Jul. 13, '48	12 15
	Trucking 1 hr. @ .75	75		36' - 3/4" Copper Tubing @ .255	9 18
	Patching 15 x 3	15 00		1 - 3/4" C Corg-cock	3 00
			48 72	1 - 3/4" C x 3/4" C Curb-cock	3 68
				1 - Box & Rod	3 55
				1 - 1/2" Straight Tail Piece	30
				1 - 1/2" Offset Tail Piece	30
				Littlefield Shovel 2 1/2 hrs. @ 7.00	17 50
				Trucking 1 hr. @ .75	75
					50 41
	Labor				

Deposited
Refunded

Hedley Press, Inc., Lexington

DATE _____

TOWN OF LEXINGTON—BOARD OF PUBLIC WORKS

WATER DIVISION

The undersigned applies for a supply of water at No. _____ St. and hereby agrees to comply with the rules and regulations as now, or at any future time, established by the Board of Selectmen.

Am't. of Estimate \$ _____


Owner _____

Am't. Paid \$ _____

Address _____

Builder _____

Sketch of Service Here

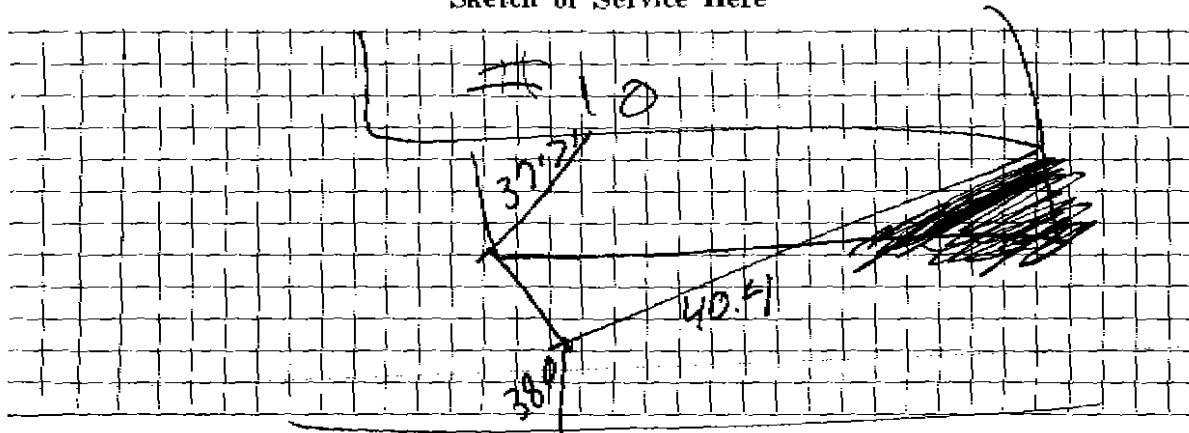

Connection made in _____ Street.

Work completed _____ 19

Remarks: