

Name ~~Ed~~ **Edel Tucci**

Service No. 176 34/6

Address 12 Briggs Road

Location 12 Briggs Road

Kind of Pipe

Size

Size of Main

~~Repair/Replacement~~ New Service

Com 12/31/47

Location

Date	Material	Amount	Total	Date	Amount
Sept. 19, '47	Labor	13 67	13 67	Mar 18 '48	12 00
	10% Overhead		1 37	April 12 '48	22 54
	78' - 3/4" Copper Tubing @.26	20 28			84 54
	1 - 3/4" C x 1/2" I.W.H. S & W	3 15			
	1 - 3/4" C x 3/4" C Union #3 pts	1 32		Sept. 18, '47	8 40
	Shovel-Tractor-Trailer		14 00	25' - 3/4" Copper Tubing @.26	6 50
	Patching 30 x 3		30 00	1 - 3/4" C x 3/4" C Curb-cock	3 68
	Trucking 1 hr. @ .75		75	1 - 3/4" C Corp-cock	3 00
			84 54	1 - Box & Rod	4 26
				Shovel-Trailer-Tractor	7 00
				Trucking 1 hr. @.75	75
					33 59
	Labor				

Bill Lev 1/8/48

TOWN OF LEXINGTON - BOARD OF PUBLIC WORKS

WATER DIVISION

The undersigned applies for a supply of water at No..... St. and hereby agrees to comply with the rules and regulations as now, or at any future time, established by the Board of Selectmen.

Am't of Estimate \$.....


Owner

Am't Paid \$.....

Address

Builder

Sketch of Service Here

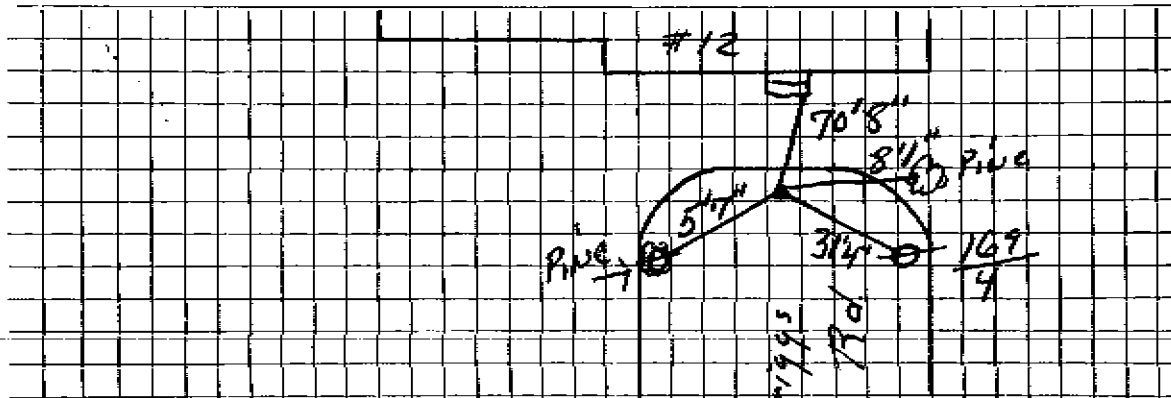

Connection made in Street.

Work completed19

Remarks: