

Name Lexington Homes, Inc.

Check from A. David Bjorkgren

Service No. ~~88~~ 410

Address 2 Briggs Rd.  
Lexington, Mass.

Location 2 Briggs Road.

Kind of Pipe

Size

Size of Main

Repair—Renewal—New Service

Location

Date  
1941

Material

Amount

Total

Date

Amount

Sept. 3,  
Com 9/12/41

2 hrs. @ 60¢ 1 20  
10% Overhead 12  
37' 3/4" Copper tubing 190  
1 3/4" C.x $\frac{1}{2}$ " I.S.&W. 2 50  
2 hrs. trucking @ 75¢ 1 50

1 32  
7 03  
2 50  
1 50  
12 35

August 28, 1941 deposited  
September 16, 1941 Refunded

16 00  
3 65  
12 35

Labor

Ladley Press, Inc., Lexington

DATE Aug 25

TOWN OF LEXINGTON—BOARD OF PUBLIC WORKS  
**WATER DIVISION**

The undersigned applies for a supply of water at No. 2 Briggs Rd St. and hereby agrees to comply with the rules and regulations as now, or at any future time, established by the Board of Selectmen.

Am't. of Estimate \$ 16


Owner Lexington Homes Inc

Am't. Paid \$ \_\_\_\_\_

Address 57 Bedford St  
Lexington

Builder David Bjorkgren

Sketch of Service Here

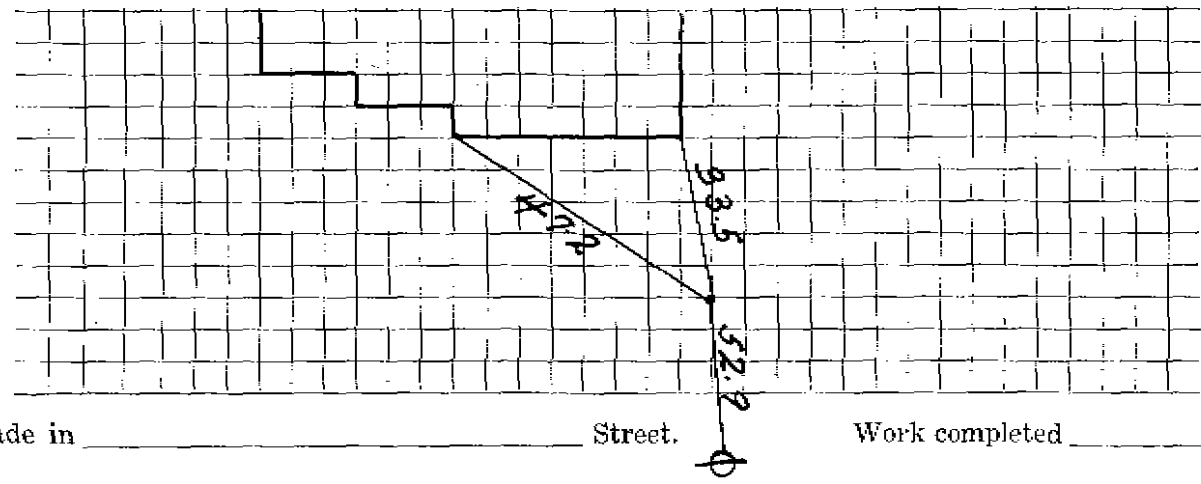

Connection made in \_\_\_\_\_ Street.

Work completed \_\_\_\_\_ 19\_\_

Remarks: