

Name Lexington Homes, Inc.

Check from:

A. David Bjorkgren

Service No. ~~00~~ 411

Address

~~3 Briggs Rd.
Lexington, Mass.~~

6418

Location

3 Briggs Road

7624

Kind of Pipe

Size

Size of Main

Repair—Renewal—New Service

Location

Date
1941

Material

Amount

Total

Date

Amount

Sept. 3,

2 hrs., @ 60¢

1 20

10% Overhead

12

1 32

40' 3/4" Copper tubing @

19¢

7 60

1 3/4 C.x 1/2" I.S. & W.

2 50

2 hrs. trucking @ 75¢

1 50

12 92

August 27, 1941

Deposited

16 00

September 16, 1941

Refunded

3 08

12 92

Labor

Hadley Press, Inc., Lexington

DATE _____

TOWN OF LEXINGTON—BOARD OF PUBLIC WORKS

WATER DIVISION

The undersigned applies for a supply of water at No. 3 Briggs Rd St. and hereby agrees to comply with the rules and regulations as now, or at any future time, established by the Board of Selectmen.

Am't. of Estimate \$


Owner Lyington Homes Inc

Am't. Paid \$

Address 57 Bedford St
Lexington

Builder A D Bjorkum

Sketch of Service Here

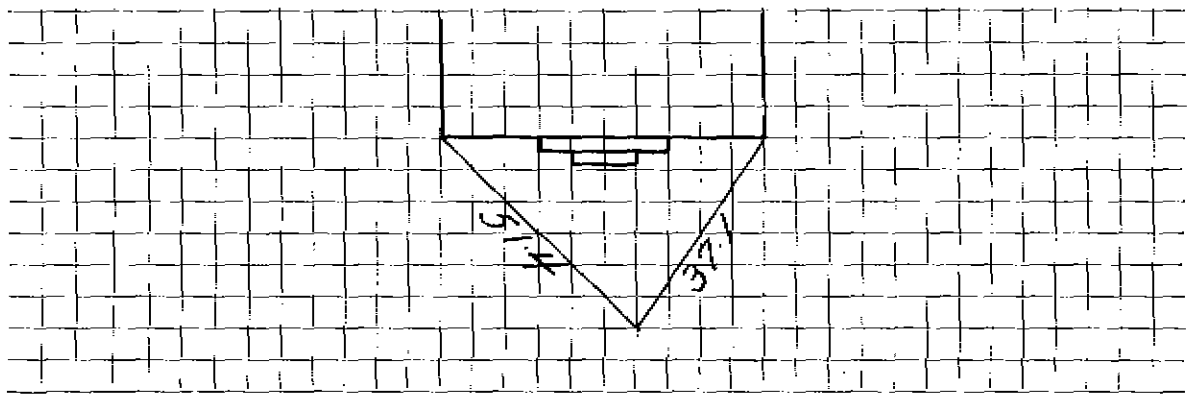

Connection made in _____ Street.

Work completed _____ 19

Remarks: