

# WATER SERVICE RECORD

Name

Service No.

Address *7 Briggs Rd.*

Location

Repair—Renewal—New Service


Date	Material	Amount	Total	Date	Amount
?	57' 1" Copper			April 2 -48	Outside
					12' 3/4" Copper
					1 - 3/4" Corp
					1 - 3/4" Curb
					1 - BOX + Rod

DATE \_\_\_\_\_

TOWN OF LEXINGTON — BOARD OF PUBLIC WORKS

WATER DIVISION

Sketch of Service Here

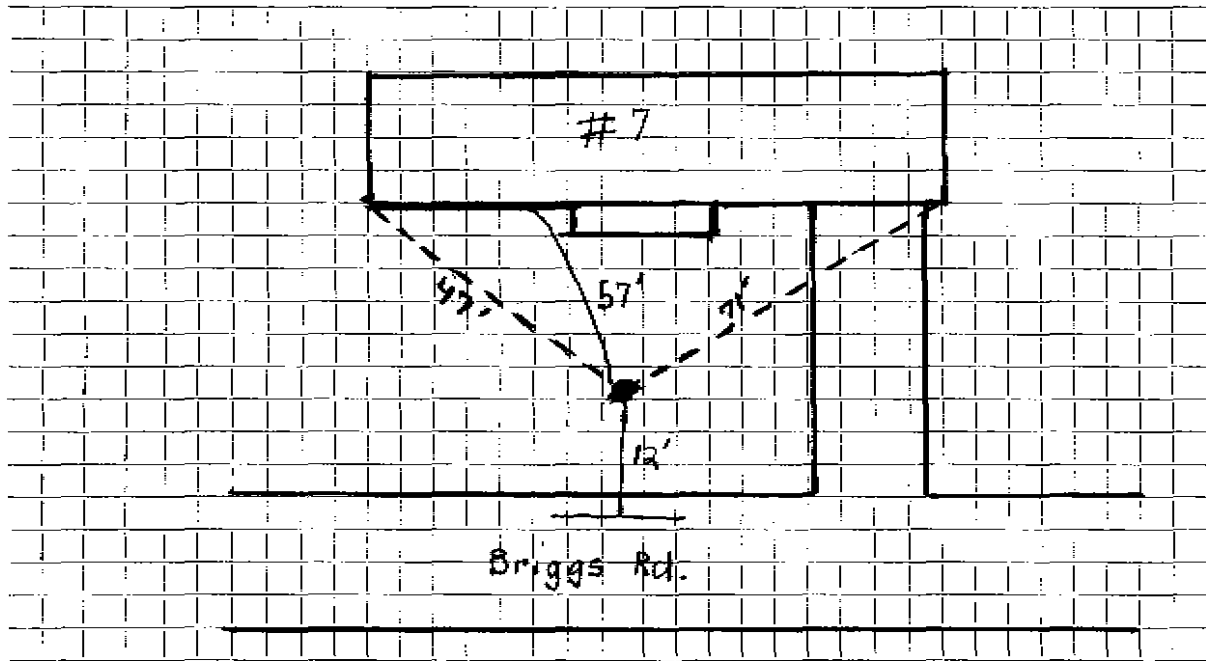

Connection made in ..... Street. Work completed .....

Remarks: ..... 57' 1" inside .....  
..... 12' 3/4" outside .....