

Name Harold Johanson

Service No. 186 8424

Address 8 Briggs Road - 66 *Briggs Road*

#6011

Location 8 Briggs Road

Kind of Pipe

Size

Size of Main

~~Repair~~ ~~Renewal~~ - New Service

Com 12/13/47

Location

Date	Material	Amount	Total	Date	Amount
12/16/47	Labor	1 05	1 05	12/13/47	50 00
	10% Overhead	11	11	12/31/47	5 54
	40' $\frac{3}{4}$ " Copper Tubing @	.26	10 40		<hr/> 44 46
	1 $\frac{3}{4}$ " Cx $\frac{1}{2}$ " I.W.H. S&W		3 15		Non Charge
	2 hrs. Hired Shovel @	7.00	14 00	1.16.47	Labor 2.80
	1 hr. Trucking		75	17	Labor 4.95
	Patching 15x3		15 00		18' $\frac{3}{4}$ " C. Tubing @ .26
			44 46		1 $\frac{3}{4}$ " C. Corp. Cock
					1 $\frac{3}{4}$ " Cx $\frac{3}{4}$ " C. Curb-cock
					1 Box and Rod
					1 $\frac{1}{2}$ " Offset Tailpeice
					1 $\frac{1}{2}$ " Str. Tailpeice
					$\frac{1}{2}$ hr. Hired Shovel @ 7.00
					1 hr. Trucking
					<hr/> 28 22
	Labor				

TOWN OF LEXINGTON – BOARD OF PUBLIC WORKS

WATER DIVISION

The undersigned applies for a supply of water at No. St. and hereby agrees to comply with the rules and regulations as now, or at any future time, established by the Board of Selectmen.

Am't of Estimate \$.....


Owner

Am't Paid \$.....

Address

Builder

Sketch of Service Here

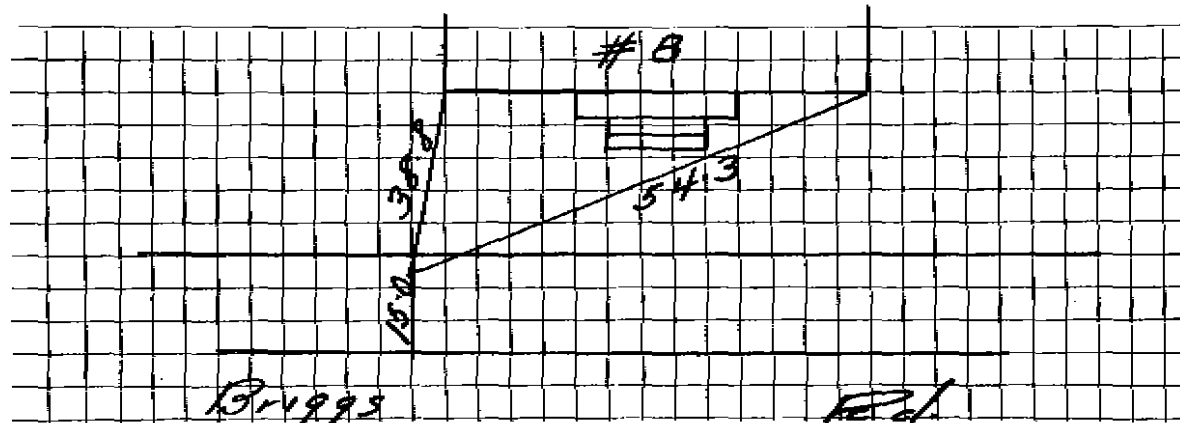

Connection made in Street.

Work completed19

Remarks: