

Name Walter R. Elander

Service No. 5

Address 9 Briggs Road

#5508

Lexington, Mass.

Location 9 Briggs Road

Kind of Pipe

Size

Size of Main

Repair - New Service

Com. 2-21-49

Location

Date	Material	Amount	Total	Date	Amount
Jan. 8, '49	Labor	7 85	7 85	Jan. 7, '49	75 00
	10% Overhead		79	Feb 24 '49	8 64
	50' - 3/4" Copper Tubing @.27		13 50		66 36
	1 - 3/4" C x 1/2" I.W.H. S&W		3 15		
	1 - 3/4" C x 3/4" C Union (6pt)		1 32	Jan. 8, '49	6 00
	Littlefield Shovel 2 hrs. @7.00		14 00	30' - 3/4" Copper Tubing @.27	8 10
	Trucking 1 hr.		75	1 - 3/4" C Corp-cock	3 00
	Patching 25 x 3		25 00	1 - 3/4" x 3/4" C Curb-cock	3 68
			66 36	1 - Box & Rod	3 55
				1 - 1/2" Offset Tail Piece	30
				1 - 1/2" Straight Tail Piece	30
				Littlefield Shovel 1 1/2 hrs. @7.00	10 50
				Trucking 1 hr.	75
	Labor				36 18

Deposited
Refunded
Non-Charge

DATE _____

TOWN OF LEXINGTON - BOARD OF PUBLIC WORKS

WATER DIVISION

The undersigned applies for a supply of water at No..... St. and hereby agrees to comply with the rules and regulations as now, or at any future time, established by the Board of Selectmen.

Am't of Estimate \$.....


Owner

Am't Paid \$.....

Address

Builder

Sketch of Service Here

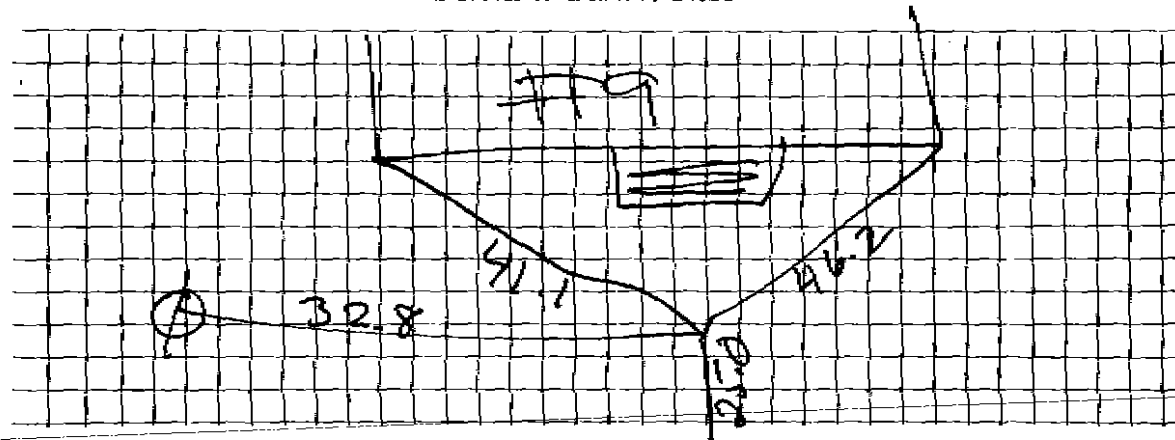

Connection made in Street.

Work completed19

Remarks: *50' 3/4" C.T. inside*
30' 3/4" C.T. outside