

WATER SERVICE RECORD

Name J.M. Lucente

Service No. 28

Address Brigham Road & Hancock Street (Tapping Sleeve)

Location

~~Repair Record~~ — New Service

Comm 12-31-65


| Date | Material | Amount | Total | Date | | Amount |
|---------|------------------|--------|--------|----------------|-----------------|---------------|
| 4-30-65 | Labor | 78 71 | | <i>4-30-65</i> | <i>Deposit</i> | <i>200 00</i> |
| | 10% O.H. | 7 87 | 86 58 | <i>4-31-65</i> | <i>Retained</i> | <i>98 99</i> |
| 15 | Lbs. Jute @.32 | | 4 80 | | | <i>101 03</i> |
| 1 | Lb. Leadite @.15 | | 15 | | | |
| 1 | Hr. Town Shovel | | 6 50 | | | |
| 1 | Hr. Town Truck | | 3 00 | | | |
| | | | 101 03 | | | |

DATE _____

TOWN OF LEXINGTON — BOARD OF PUBLIC WORKS

WATER DIVISION

Sketch of Service Here

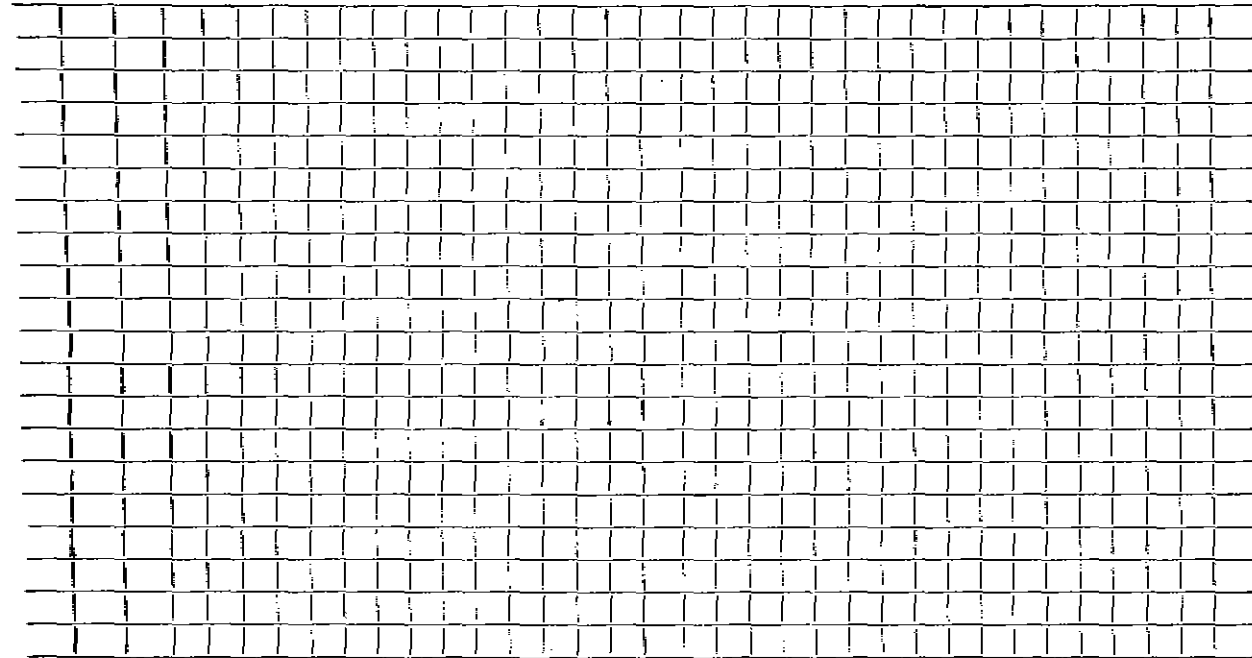

Connection made in Street. Work completed

Remarks:
.....
.....