

Name

Service No. 416

Address 24 Brookside Ave.

#5487  
#6410  
#0893

Location 24 Brookside Ave.

Kind of Pipe

Size

Size of Main

Repair—Renewal—New Service

Location

Date

Material

Amount

Total

Date

Amount

Inside  
Iron Pipe

checked 11-5-91  
Outside:  
3/4 Copper

Labor

# TOWN OF LEXINGTON—BOARD OF PUBLIC WORKS WATER DIVISION

The undersigned applies for a supply of water at No. \_\_\_\_\_ St. and hereby agrees to comply with the rules and regulations as now, or at any future time, established by the Board of Selectmen.

Am't. of Estimate \$ \_\_\_\_\_

Owner


Am't. Paid \$ \_\_\_\_\_

Address

J. Kavanaugh.  
24 Brookside ave

Builder \_\_\_\_\_

Sketch of Service Here

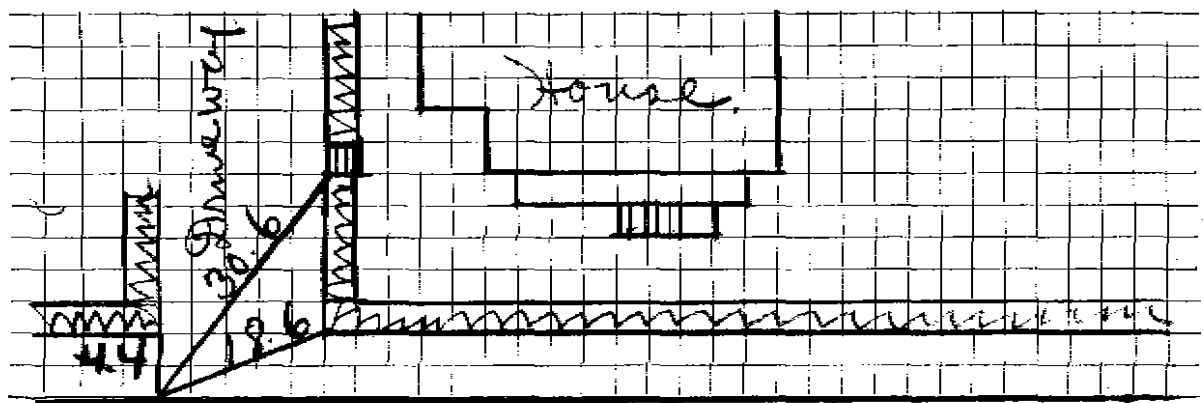

Connection made in Brookside Street and Work completed \_\_\_\_\_ 19

Remarks: