

WATER SERVICE RECORD

#5326

Name Joel Gardiner & Sons Inc.

Service No. 85

Address 26 Brookside Avenue

Location

~~Repair~~ ~~Renewal~~ - New Service WO #7454

Comm 10-1-62


Date	Material	Amount	Total	Date	Amount	
7/11/62	Labor	51 05		7-9-62	Deposit	150 00
	10% O.H.	5 11	56 16	10-1-62	Retund	29 69
7/11/62	3/4" Copper Tubing @ .42		29 82			120 31
	1 3/4" Cx 1/2 IWH Stop & Waste		6 17			
	1 3/4" C 3 Part Union		2 41	7/11/62	Labor	8 20
	2 1/2 Hrs. Town Shovel @ 5.50		13 75		12 3/4" Copper Tubing @ .42	5 04
	2 Hrs. Trucking @ 3.00		6 00		1 3/4" Corp. Cock	4 91
	6 X 3 Patch		6 00		1 3/4" C Curb Cock	6 28
			120.31		1 Bow & Rod	4 90
					1 1/2 Straight Tailpiece	50
					1 1/2 offset Tailpiece	50
					1/2 Hr. Town Shovel @ 5.50	2 75
						33 08

TOWN OF LEXINGTON — BOARD OF PUBLIC WORKS

WATER DIVISION

DATE _____

Sketch of Service Here

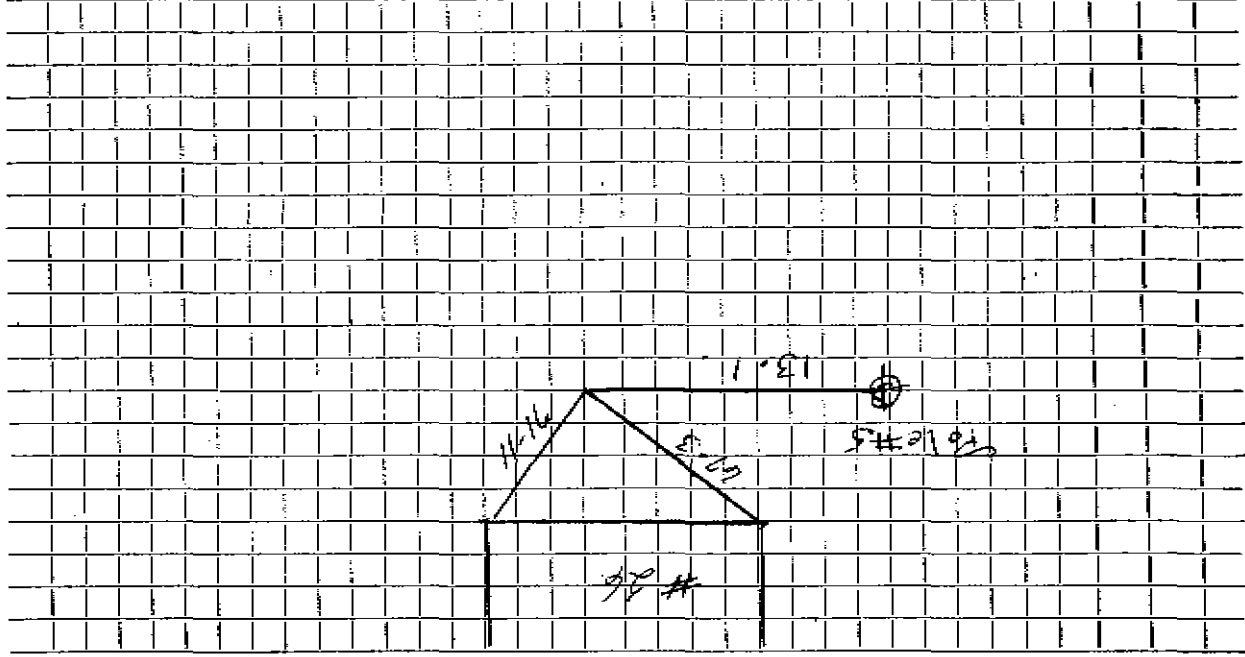

Work completed

Street _____

Connection made in _____

Remarks: _____

