


DATE _____

TOWN OF LEXINGTON — BOARD OF PUBLIC WORKS

WATER DIVISION

Sketch of Service Here

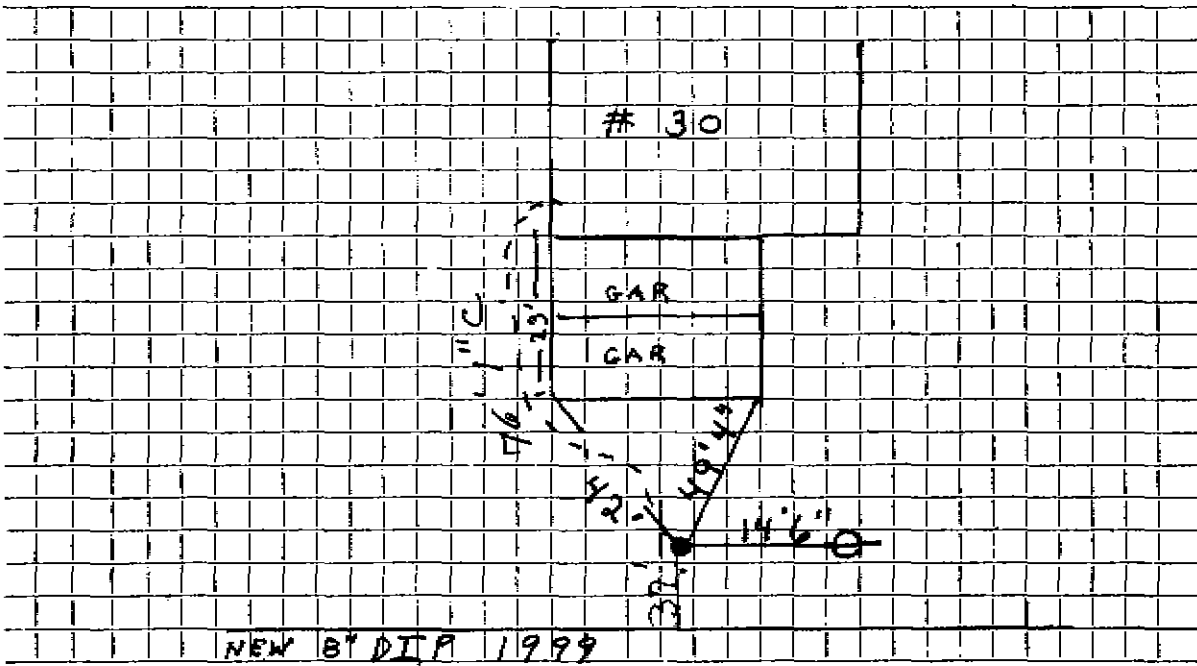

Connection made in Brookside Street. Work completed IN 3/24/00

Remarks:

.....

.....