

WATER SERVICE RECORD

Name Robert Ericson

Service No. 123

Address 6 Brookside Ave.

Location

Repair - ~~Reconnect~~ - New Service

Comm 11-17-58


Date	Material	Amount	Total	Date	Amount	
6/26/58	Labor	44 64		6-24-58	Deposit	150 00
	10% overhead	4 46	49 10	11-17-58	Retund	72
	165'-3/4" copper tubing @ .37		61 05			149 28
	1-3/4" C x 1/2" I.W.H. stop & waste	5 84			NON CHARGE	
	2-3/4" C 3 part unions @ 2.27	4 54	6/26/58	Labor	5 84	
	6 x 3 Patch		6 00	10'-3/4" copper tubing @ .37	3 70	
	2 hrs. Town Shovel @ 6.50	13 00		1-3/4" C Corp Cock	4 64	
	1 hr. trucking @ .75		75	1-3/4" C Curb Cock	6 03	
	1 hr. Rodgers Trailer @ 3.00	3 00		1 Box & Rod	5 00	
	1 hr. trucking @ 3.00	3 00		1-1/2" straight tail piece	50	
	1 hr. Allis Chalmers @ 3.00	3 00		1-1/2" offset tail piece	50	
				1 hr. Town Shovel @ 6.50	6 50	
			149 28		32 71	

DATE \_\_\_\_\_

**TOWN OF LEXINGTON — BOARD OF PUBLIC WORKS**

**WATER DIVISION**

Sketch of Service Here

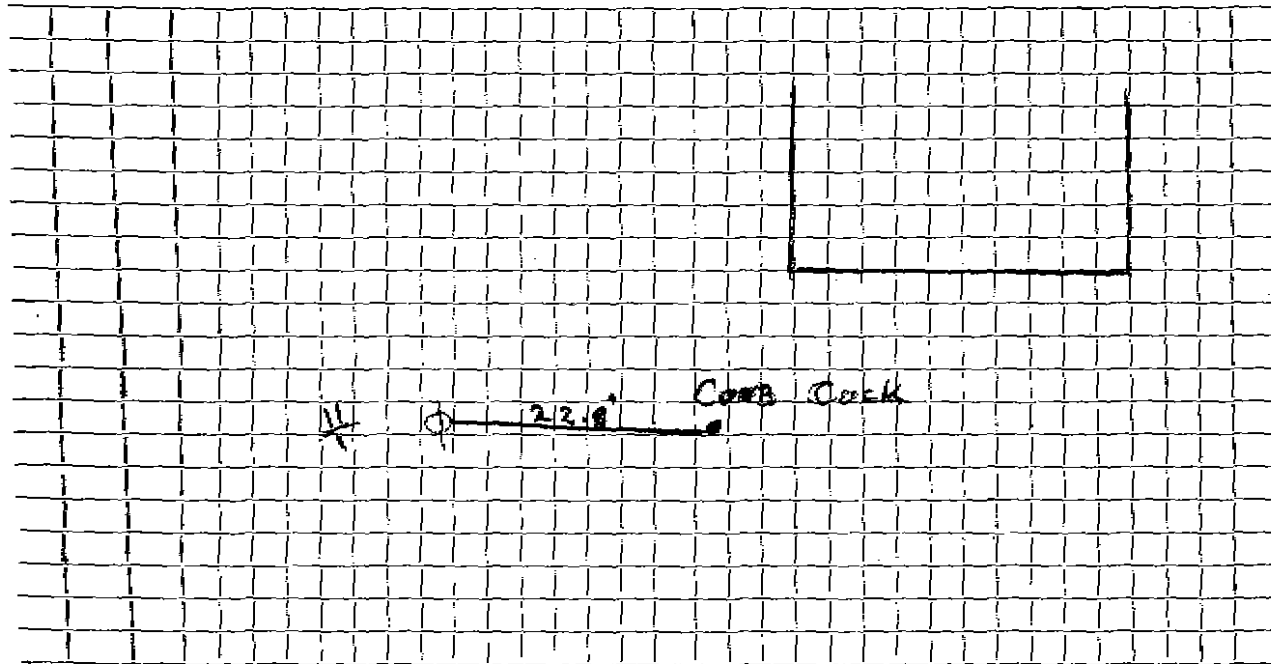

Connection made in ..... Street. Work completed .....

Remarks: .....  
.....  
.....