

WATER SERVICE RECORD

Name Cardinal Associates

Service No.

Address #6 Brookwood Rd.

Location

Repair—Renewal—New Service Lucente #2251


Date	Material	Amount	Total	Date	Amount
1-25-73	63' 3/4" Copper			5/15/70	13' 3/4" COPPER
					1' 3/4" CORP
					3/4" CURB
					Box & Rod

DATE _____

TOWN OF LEXINGTON -- BOARD OF PUBLIC WORKS

WATER DIVISION

Sketch of Service Here

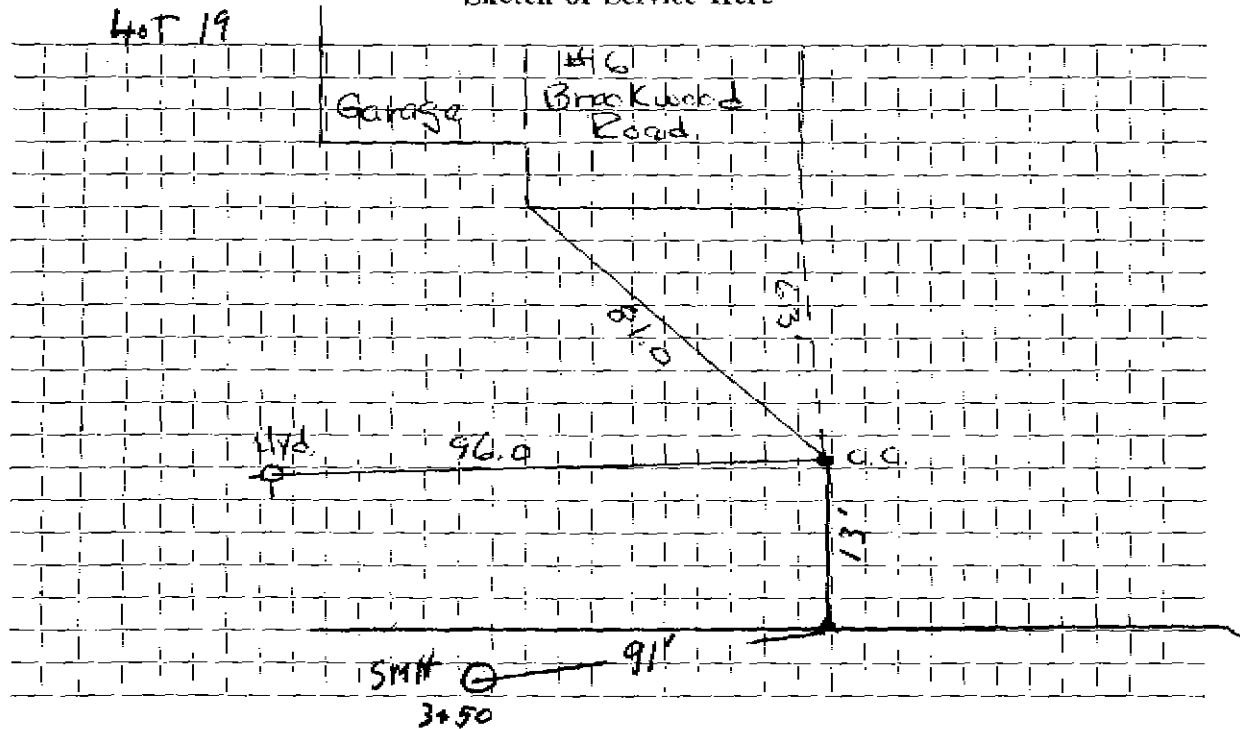

Connection made in Street. Work completed

Remarks:

.....

.....