




TOWN OF LEXINGTON -- BOARD OF PUBLIC WORKS

WATER DIVISION

Sketch of Service Here

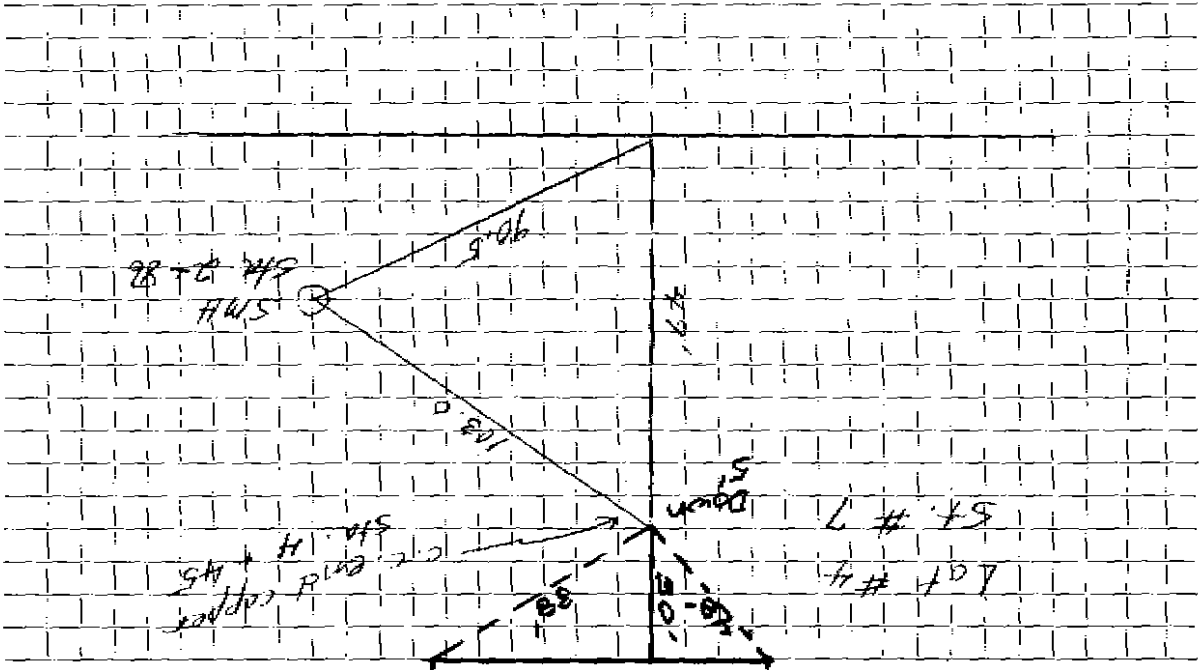

Connection made in 7. Brookwood Street.

Work completed

12/6/74

Remarks:

DATE