
Name Oak Park Corp. Address 9 Brookwood Rd. Location				WATER SERVICE RECORD Service No.						
Her	RRECAIN	wek-New Serv	ice Lucent	e #1584	Bruce M	cKee #3277				
Date	<u> </u>	Material	Am	iount	Total	Date				Amount
6-10-70	45'	3/4" copper t	ubing							
5/20/77	100	3/4" copper t	ubing	! ! 			<u> </u>			
	 _ 		<u> </u>			- 	 			
 -					<u>-</u>		' - 			- -
	· - -			<u>-</u>			ļ		···	
	- !	 - -		— - <u>-</u> -		$-\parallel$	 			
	1	- -		_+-						
										
	<u> </u>			' 		_ !!	ļ			! -
	- - - -			_			, _	<u>-</u>		<u> </u>
					·		· 			
	- <u> </u> <u>-</u>	· ———								
: 					<u>·</u>	- j -	 +		-	
						!	<u> </u>			i
	- 		:	!	<u> </u>	_	— i			
 -	_ _						l ———	·		
								_ _ _		

DATE	
------	--

TOWN OF LEXINGTON - BOARD OF PUBLIC WORKS

WATER DIVISION

Sketch of Service Here

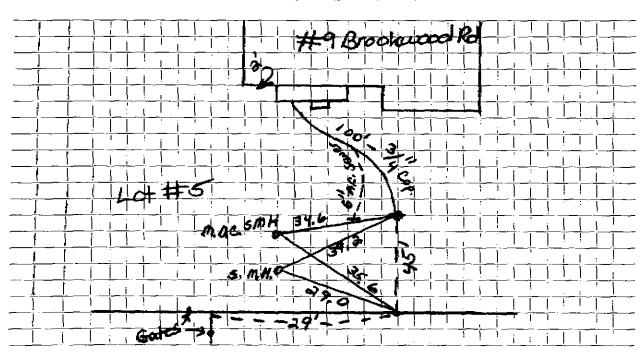

Connection made in .	Street.	Work completed
Pomorke:		