

WATER SERVICE RECORD

6727

Name Arlex Realty Trust

Service No. 249

Address 3 Brown Road

Location

~~REPAIR/RENEWAL~~ - New Service

Cont 12-12-60


Date	Material	Amount	Total	Date	Amount	
11-15-60	Labor	7 99		10-32-60	Deposit	75 00
	10% O.H.	80	8 79	2-11-60	Retard	22 29
77'	3/4" Copper Tub. @.42		32 34			52 71
1	3/4" Cx 1/2 I.W.H. Stop & Waste		6 17			
1	3/4" 3 part union		2 41		Labor	2 39
1	Hr. Trucking @ 3.00		3 00	23'	3/4" Copper tub. @.42	9 66
			52 71	1	3/4" C Corp Cock	4 91
				1	3/4" C Curb Cock	6 28
				1	Box & Rod	4 90
				1	1/2 Straight tailpiece	50
				1	1/2 offset tailpiece	50
						29 14

DATE _____

TOWN OF LEXINGTON — BOARD OF PUBLIC WORKS

WATER DIVISION

Sketch of Service Here

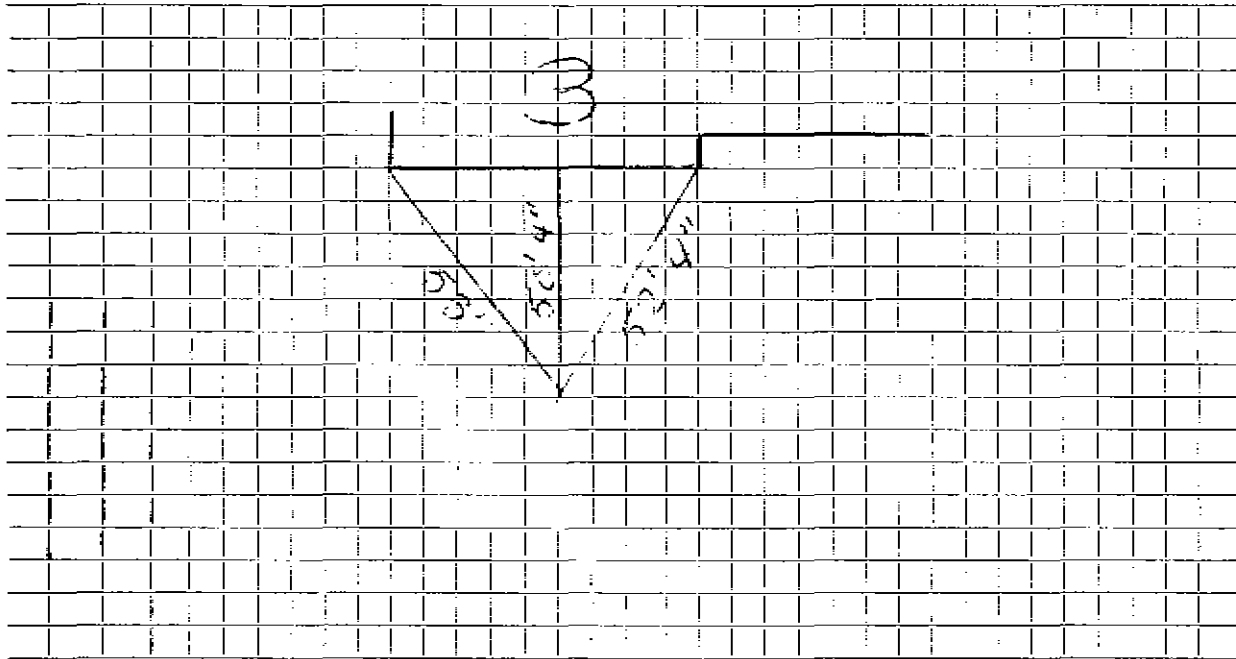

Connection made in Street. Work completed

Remarks:
.....
.....