

# 5553

WATER SERVICE RECORD

Name Arlex Realty Trust

Service No. 251

Address 5 Brown Road

Location

Repair ~~Renewal~~ New Service

Conn 12-12-60


Date	Material	Amount	Total	Date	Amount
11-15-60	Labor	14 53		10-27-60	25 00
	10% O.K.	1 45	15 98	11-12-60	13 77
140	3/4" Copper tubing @42		58 80		88 77
1	3/4" Cx <sup>1/2</sup> I.B.S. Stop&Waste		6 17		
2	3/4" Cc part Union @2.41		4 82		NON CHARGE
1	Er. Trucking @3.00		3 00	11-15-60	Labor 1 94
			38 77	12'	3/4" Copper tubing 7 56
				1	3/4" CCorp Cock 4 91
				1	3/4" CCurb Cock 6 28
				1	Box & Rod 4 90
				1	3/4" Straight tailpiece 50
				1	3/4" Offset tailpiece 56
					26 59

DATE \_\_\_\_\_

TOWN OF LEXINGTON — BOARD OF PUBLIC WORKS

**WATER DIVISION**

Sketch of Service Here

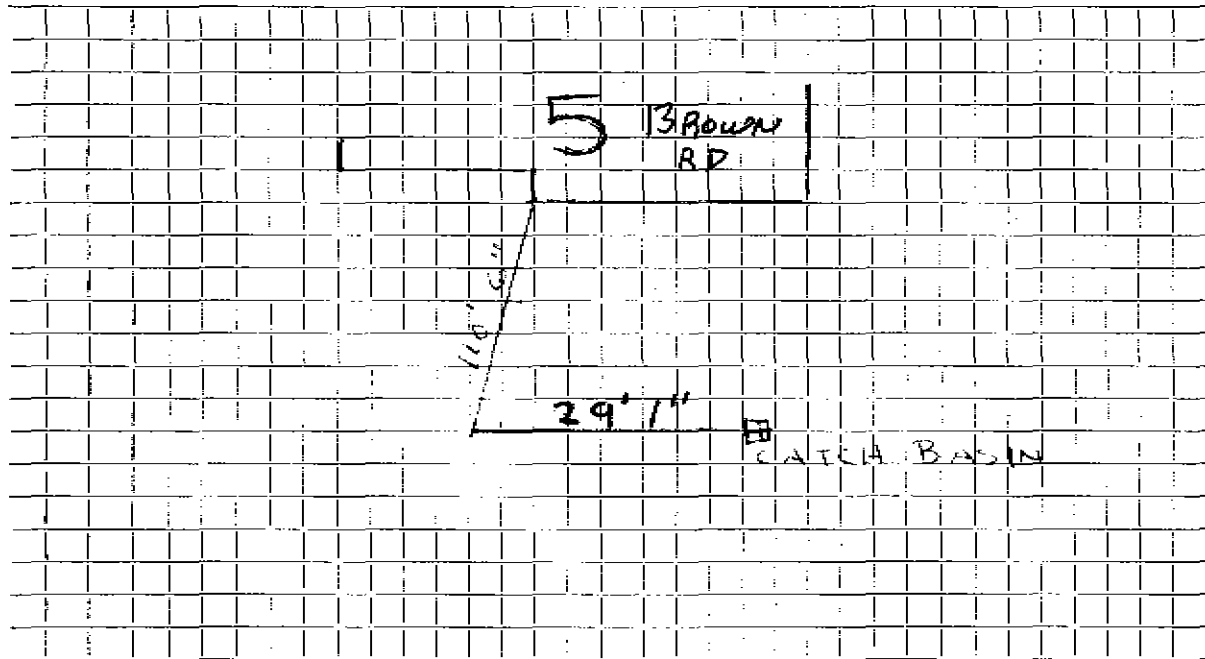

Connection made in ..... Street. Work completed .....

Remarks: .....

.....

.....