

WATER SERVICE RECORD

#5297

Name Arlex Realty Trust

Service No. 252

Address 6 Brown Road

Location

~~Repair/ Renewal~~ - New Service

*Conn 12-12-60*

Date	Material	Amount	Total	Date	Material	Amount
11-15-60	Labor	7.79		11-17-60	Deposit	75.00
	10% O.H.	.78	8.57	12-19-60	<del>Return</del>	23.35
75'	3/4" Copper tubing @.42		31.50			31.65
1	3/4" C x 1/2 IWH Stop & Waste	6.17			NON CHARGE	
1	hr. Trucking @3.00	3.00	3.00	11-15-60	Labor	1.94
1	3/4" C 3 part Union	2.41	2.41		11' 3/4" Copper tubing @.42	4.62
			51.65		1 3/4" C Corp Cock	4.91
					1 3/4" C Curb Cock	6.28
					1 Bow & Rod	4.90
					1 1/2 Straight tailpiece	.50
					1 1/2 Offset tailpiece	.50
						23.65


*A copy 13.22 to W.H.R.#251*

DATE \_\_\_\_\_

TOWN OF LEXINGTON — BOARD OF PUBLIC WORKS

**WATER DIVISION**

Sketch of Service Here

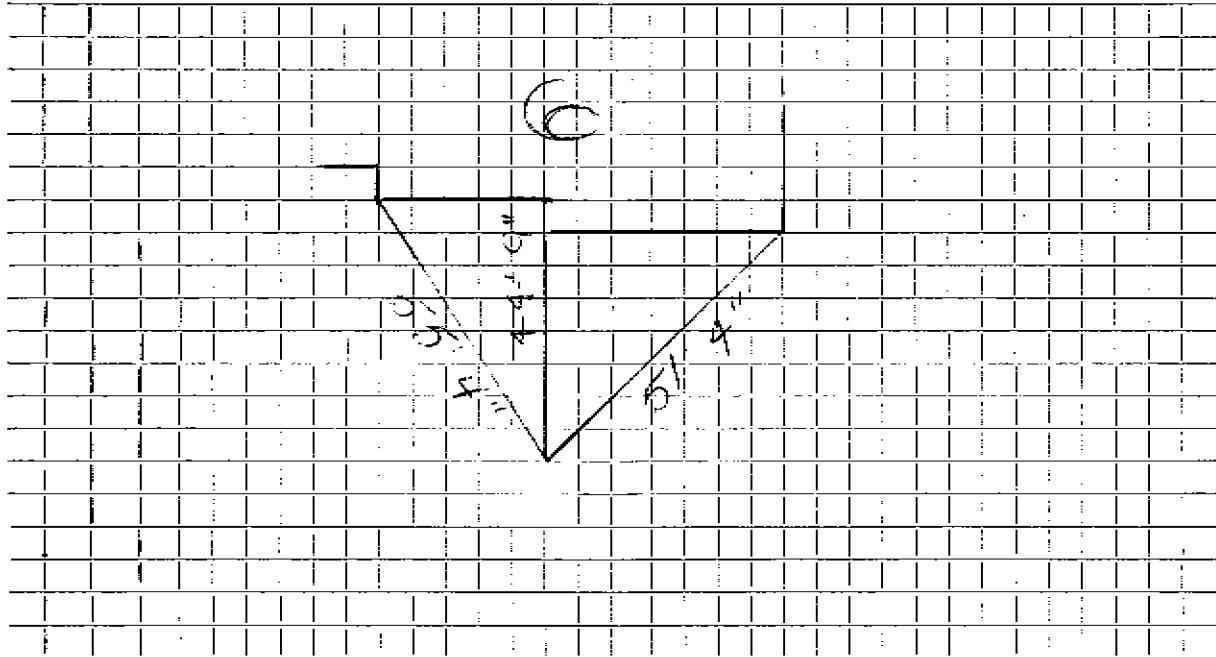

Connection made in ..... Street. Work completed .....

Remarks: .....

.....

.....