

WATER SERVICE RECORD

2432

Name Arlex Realty Trust

Service No. 253

Address 8 Brown Road

Location

~~Repair - Renewal~~ - New Service

Comm. 12-12-60


Date	Material	Amount	Total	Date		Amount
11-15-60	Labor	7.79		11-27-60	Deposit	75.00
	10% O.H.	80	8.59	12-14-60	Refund	23.33
75'	3/4" Copper tubing @.42		31.50			51.67
1	3/4" C x 1/2 IWH Stop & Waste		6.17		NON CHARGE	
1	hr. Trucking @3.00		3.00	11-15-60	Labor	1.94
1	3/4" C 3 part Union		2.41	11'	3/4" Copper tubing @.42	4.62
			51.67	1	3/4" C Curb Cock	6.28
				1	3/4" C Corp Cock	4.91
				1	Bow & Rod	4.90
				1	1/2 Straight tailpiece	50
				1	1/2 Offset tailpiece	50
						23.65

DATE _____

TOWN OF LEXINGTON — BOARD OF PUBLIC WORKS

WATER DIVISION

Sketch of Service Here

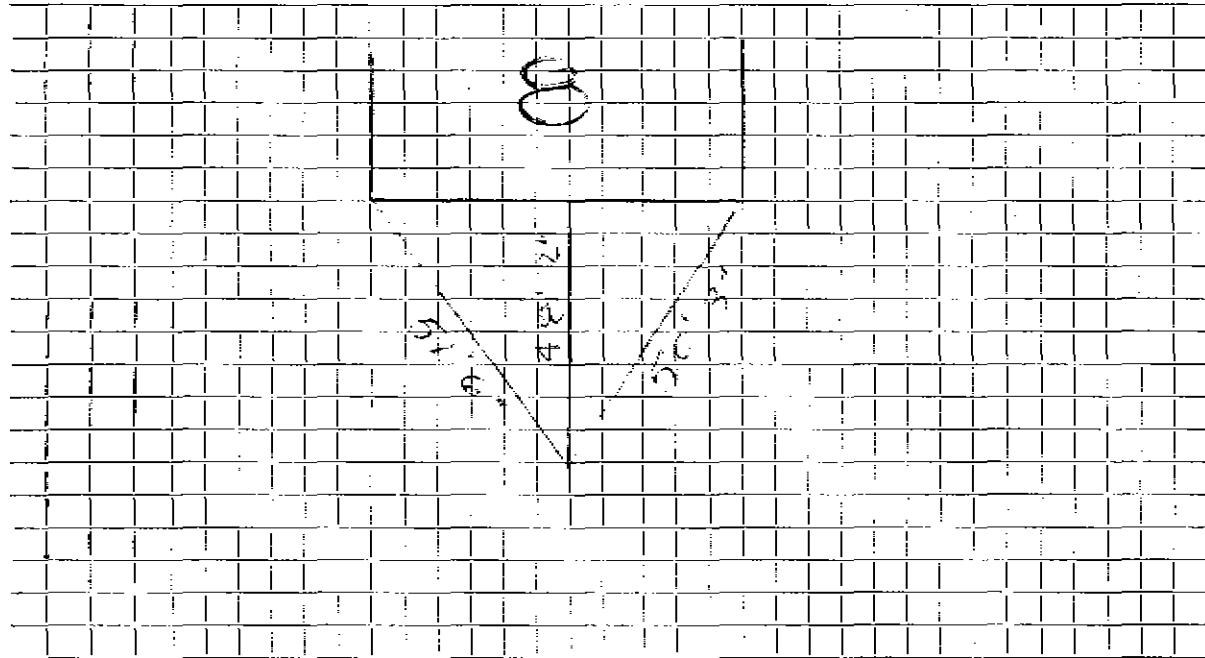

Connection made in Street. Work completed

Remarks:
.....
.....