

WATER SERVICE RECORD

Name Arlex Realty Trust

Service No. 254

Address 9 Brown Road

2863

Location

Repair—Renewal—New Service

Commitment


Date	Material	Amount	Total	Date	Amount	
11-15-60	Labor	8.10		11-15-60	Deposit	75.00
	10% O.H.	.81	8.91	11-15-60	Refund	21.75
	78' 3/4" Copper tubing @.42		32.76			53.25
	1 3/4" C x 1/2 IWH Stop & Waste		6.17		NON CHARGE	
	1 3/4" C 3 part Union		2.41	11-15-60	Labor	3.53
	1 hr. Trucking @3.00		3.00		34' 3/4" Copper tubing @.42	14.28
			53.25		1 3/4" C Corp Cock	4.91
					1 3/4" C Curb Cock	6.28
					1 Bow & Rod	4.90
					1 1/2 Straight tailpiece	.50
					1 1/2 Offset tailpiece	.50
						34.90

DATE _____

TOWN OF LEXINGTON — BOARD OF PUBLIC WORKS

WATER DIVISION

Sketch of Service Here

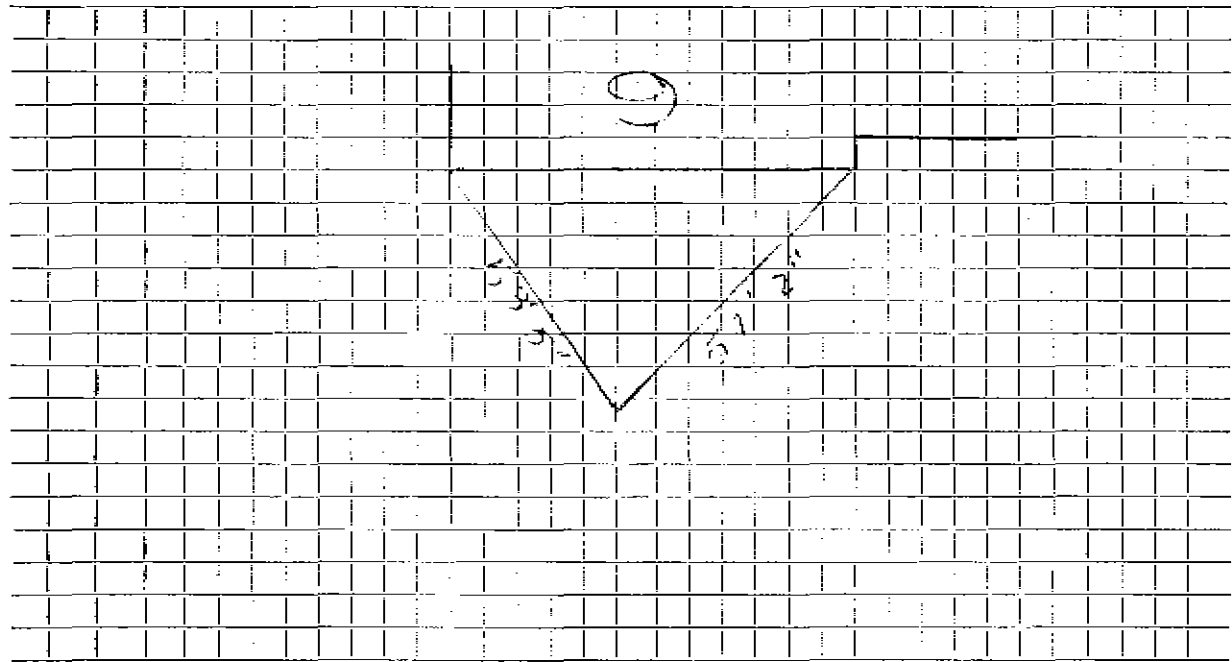

Connection made in Street. Work completed

Remarks:
.....
.....