

WATER SERVICE RECORD

Name H. Allen Jenkins

Service No. 196

Address 6 ~~Isaac~~ Bruce Street No. 200

Location Com. 9-6-55

~~Repair - Renewal~~ - New Service Service was into curb


Date	Material	Amount	Total	Date	Amount
7/27/55	Labor	1 85		6-28-55 Deposited	25 00
	10% overhead	19	2 04	9-6-55 Refunded	7 07
	29'-3/4" copper tubing @ .384		11 14	NON CHARGE	17 93
	1-3/4" Cx 1/2 I.W.H. stop & waste		4 00	7/27/55-1-3/4" offset tailpiece	50
	1 hr. trucking @ .75		75	1-3/4" straight tail piece	50
			17 93		1 00
				NON CHARGE	
				10/19/54	
				Labor	2 98
				14' 3/4" copper tubing @ .35	4 90
				1 3/4" corp cock	4 33
				1 3/4" C. curb cock	4 67
				1 box and rod	3 90
				1 hr. trucking	75
					21 53

DATE _____

TOWN OF LEXINGTON — BOARD OF PUBLIC WORKS

WATER DIVISION

Sketch of Service Here

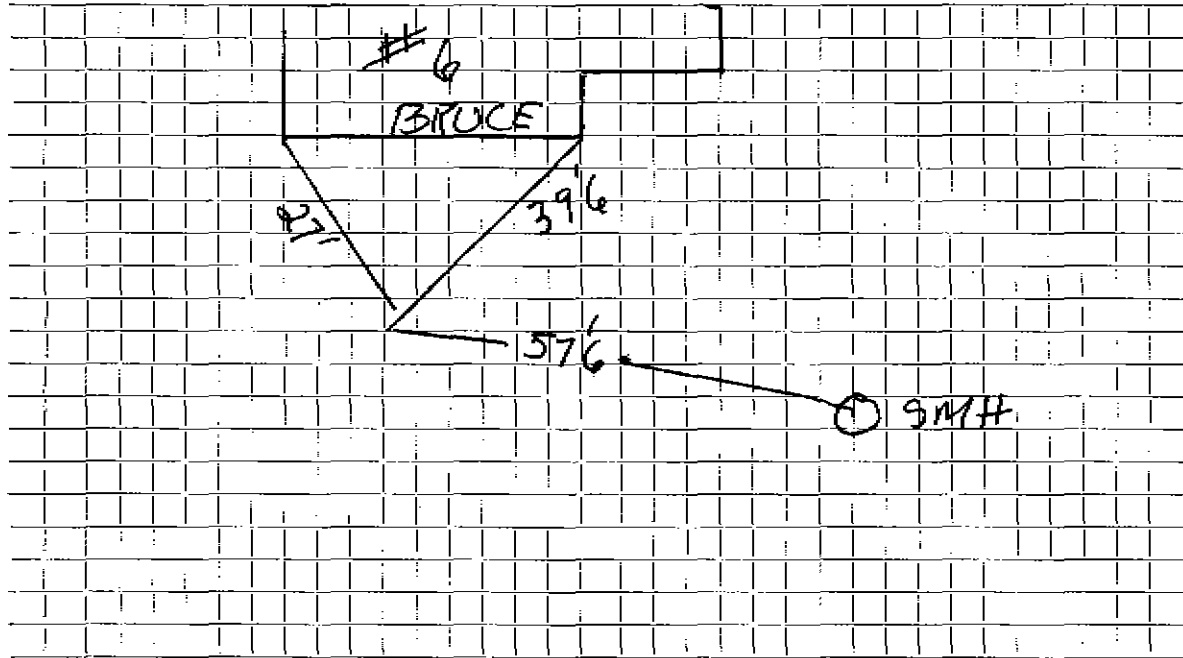

Connection made in _____ Street. Work completed _____

Remarks: _____
