

WATER SERVICE RECORD

#5706

Name H. Allen Jenkins

Service No. 348

Address 7 ~~Cambridge~~ Bruce Street Road

Location

~~Repair/Replacement~~ - New Service

Comm. 4/1/57


Date	Material	Amount	Total	Date	Amount
3/14/57	Labor	1 95		11-13-56	Deposit \$50 00
	10% overhead	20	2 15	4-1-57	Refund 22 36
	45' - 3/4" Copper tubing @	.4396	19 78		NON CHARGE \$ 27 64
	1 - 3/4" Cx 1/2 I.W.H. Stop & Waste		4 96	1 - 1/2	Straight tailpiece 50
	1 hr. trucking		75	1 - 1/2	Offset tailpiece 50
			27 64		1 00
					NON CHARGE
				10/19/54	Labor 2 98
					25' 3/4" copper tubing @ .35 8 75
					1 3/4" C. corp cock 4 33
					1 3/4" C. curb c ock 4 67
					1 box and rod 3 90
					1 hr. trucking 75
					@ 25 38

DATE \_\_\_\_\_

TOWN OF LEXINGTON — BOARD OF PUBLIC WORKS

**WATER DIVISION**

Sketch of Service Here

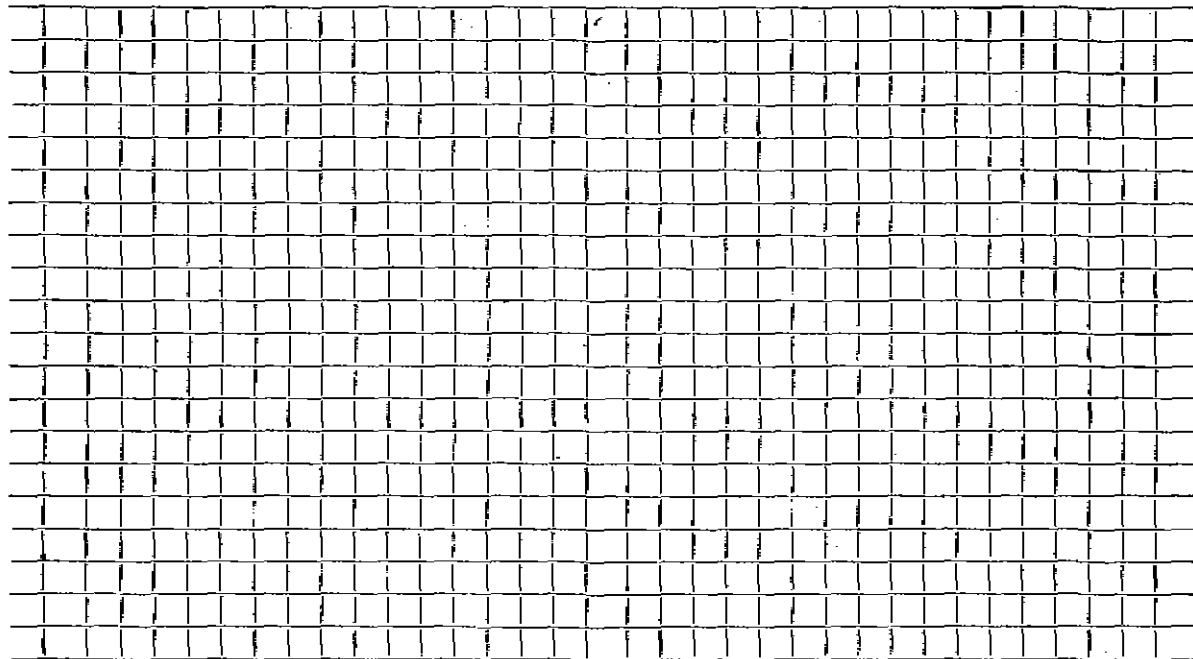

Connection made in ..... Street. Work completed .....

Remarks: .....

.....

.....