


TOWN OF LEXINGTON — BOARD OF PUBLIC WORKS
WATER DIVISION

Sketch of Service Here

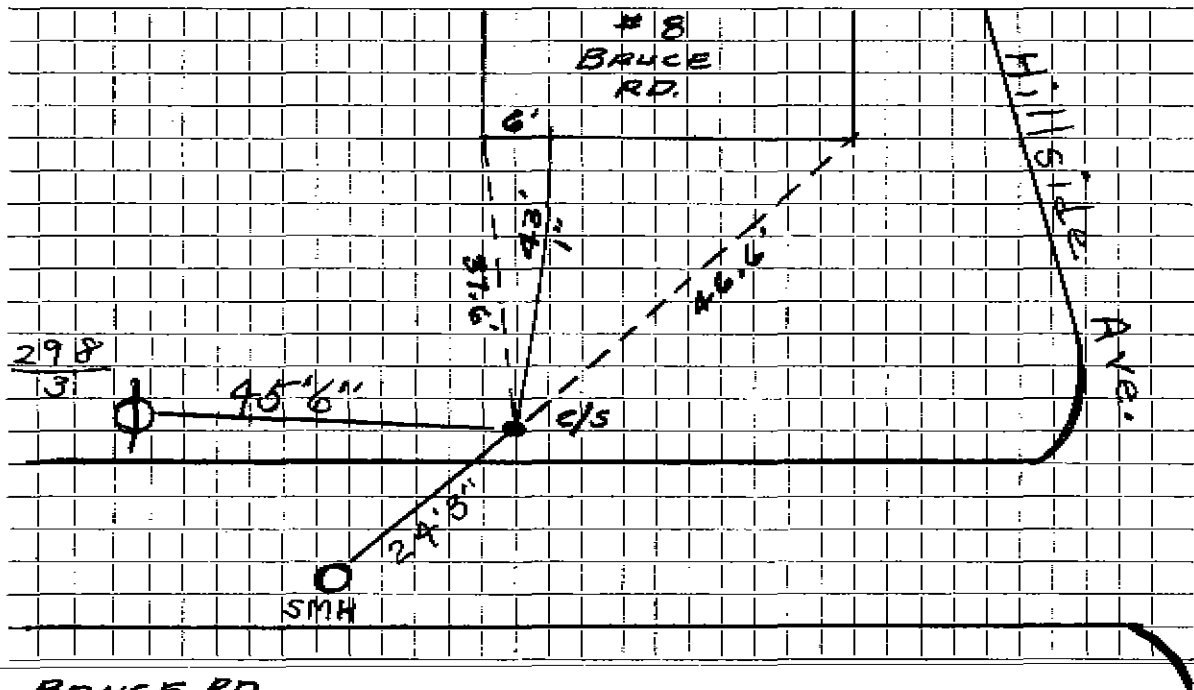

Connection made in BRUCE RD. Street. Work completed

Remarks: L.H.A.