


TOWN OF LEXINGTON — BOARD OF PUBLIC WORKS

WATER DIVISION

DATE _____

Sketch of Service Here

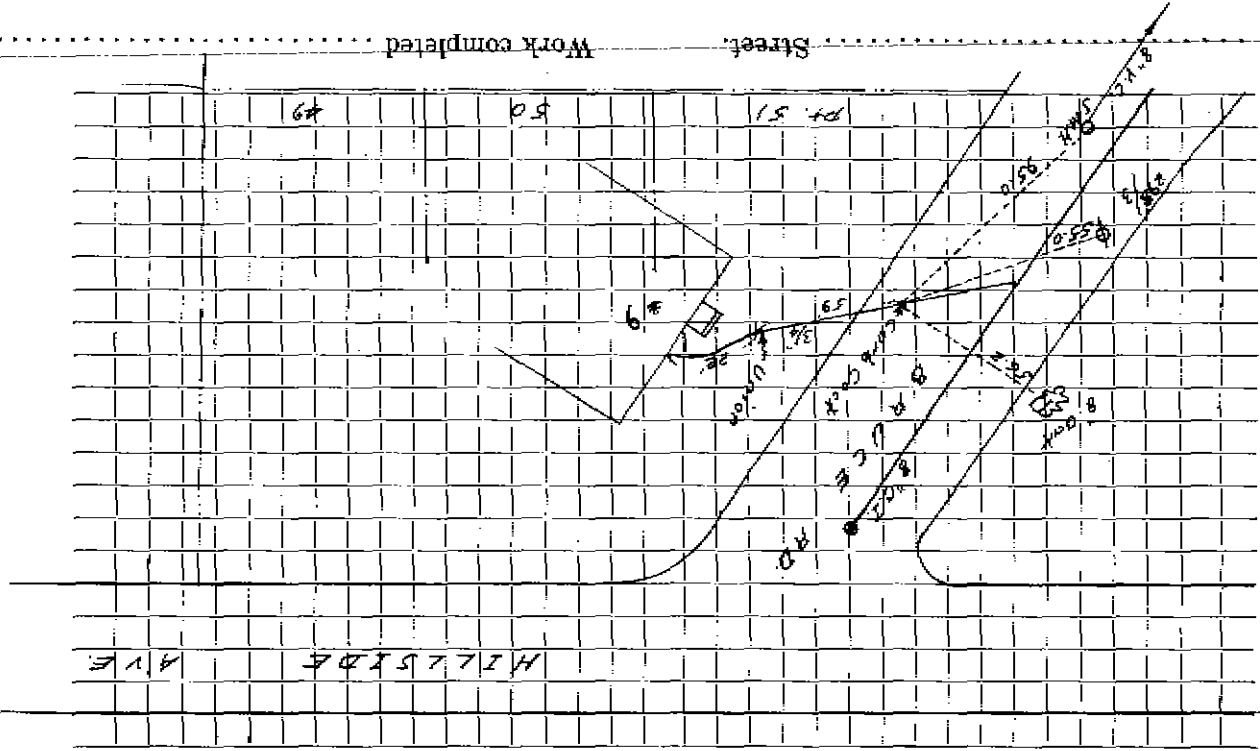

Connection made in _____

Remarks: _____

Street: _____

Work completed _____