

## WATER SERVICE RECORD

Name West Chester Est. Inc.

Service No. 134

Address 10 Bryant Road

Location

~~Repair - Renewal~~ - New Service

Comm 8-22-66


Date	Material	Amount	Total	Date	Amount	
10-2-59	Labor	1 85		7-19-60	Deposit	30 00
	10% O. H.	19	2 04	7-22-66	Paid by SA# 134	4 82
	Owner's copper					34 82
	25' out				<u>NON CHARGE</u>	
7-22-60	Labor	3 68		10-2-59	Labor	1 85
	10% O.H.	36	4 04	1	3/4" C Corp Cock	4 64
	48' 3/4" Copper tubing @ .42		20 16	1	3/4" C Curb Cock	5 94
	1 3/4" Cox I.W.E. Stop & Waste		6 17	1	Box & Rod	5 00
	1 3/4" C3 Part Union		2 41			17 43
			34 82	7-22-60	1 1/2" Straight tailpiece	50
					1 1/2" Offset tailpiece	50
						18 43

DATE \_\_\_\_\_

TOWN OF LEXINGTON — BOARD OF PUBLIC WORKS

WATER DIVISION

Sketch of Service Here

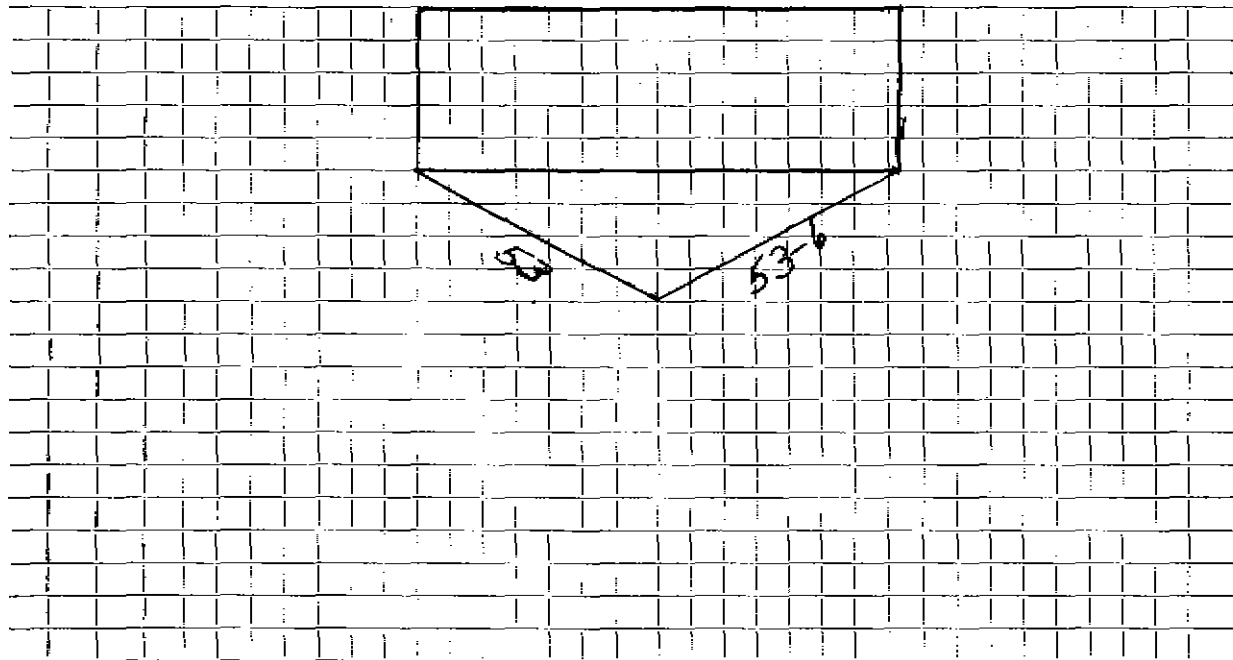

Connection made in ..... Street.      Work completed .....

Remarks: .....  
.....  
.....