

WATER SERVICE RECORD

Name DeVries Const. Co.

Service No. 139

Address 11 Bryant Road

Location

~~Repair~~ ~~Renewal~~ New Service


Comm 8-22-60

Date	Material	Amount	Total	Date	Amount	
10-2-59	Labor	1 85		7-21-60	Deposit	30 00
	10% O. H.	19	2 04	8-22-60	Paid by STC #140	3 57
	Owner's copper					33 57
	7' out				<u>NON CHARGE</u>	
7-25-60	Labor	1 77		10-2-59	Labor	1 85
	10% O.H.	18	1 95	1	3/4" C Corp Cock	4 64
50'	3/4" Copper tubing @ .42		21 00	1	3/4" C Curb Cock	5 94
1	3/4" Cx 1/2 I.W.N. Stop & Waste		6 17	1	Box & Rod	5 00
1	3/4" C3 Part Union		2 41			17 43
			33 57	7-25-60	1 1/2 Straight tailpiece	50
					1 1/2 Offset tailpiece	50
						18 43

TOWN OF LEXINGTON — BOARD OF PUBLIC WORKS

**WATER DIVISION**

Sketch of Service Here

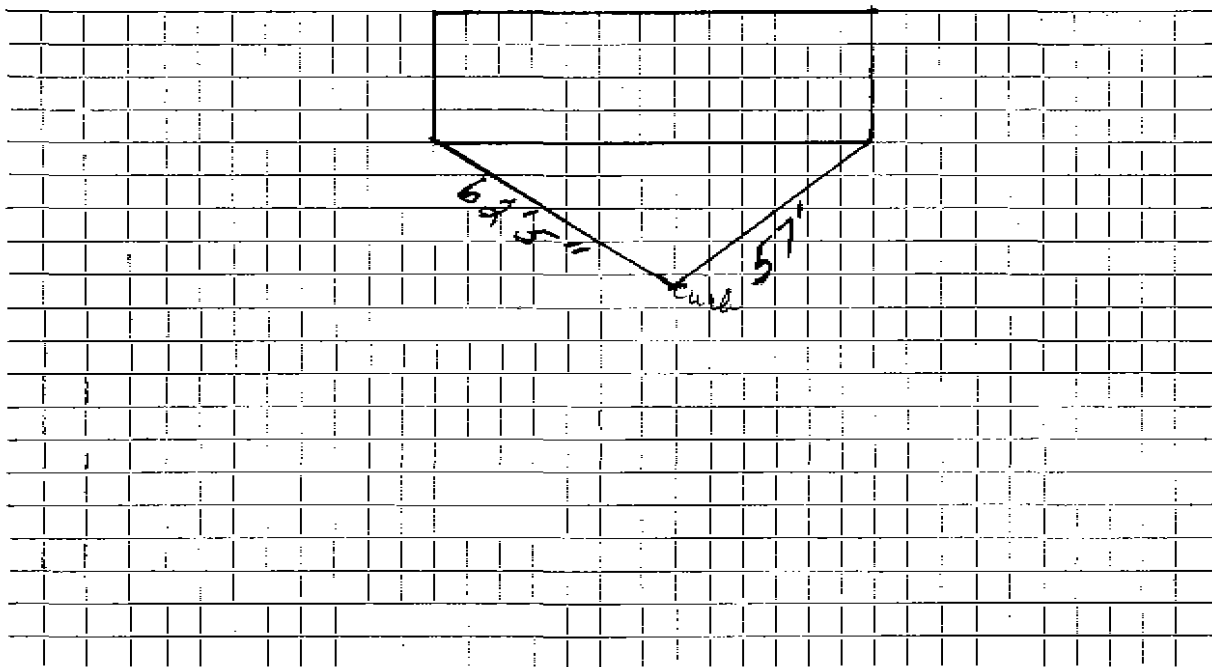

Connection made in ..... Street. Work completed .....

Remarks: .....

.....

.....