

WATER SERVICE RECORD

Name West Chester Est. Inc.

Service No. 133

Address 12 Bryant Road

Location

~~Repair - Renewal~~ - New Service


Comm 8-11-60

Date	Material	Amount	Total	Date	Amount	
10-2-59	Labor	1 85		7-19-60	30 00	
	10% O. H.	19	2 04	2-22-60	6 51	
	Owner's copper				36 51	
	26' out				<u>NON CHARGE</u>	
7-22-60	Labor	3 68		10-2-59	Labor	1 85
	10% O.H.	37	4 05	1	3/4" C Corp Cock	4 64
52'	3/4" Copper tubing @ .42		21 84	1	3/4" C Curb Cock	5 94
1	3/4" Cxt I.W.H. Stop & Waste		6 17	1	Box & Rod	5 00
1	3/4" C3 Part Union		2 41			17 43
			36 51	7-22-60	1 1/2 Straight tailpiece	50
				1	Offset tailpiece	50
						18 43

DATE _____

TOWN OF LEXINGTON — BOARD OF PUBLIC WORKS
WATER DIVISION

Sketch of Service Here

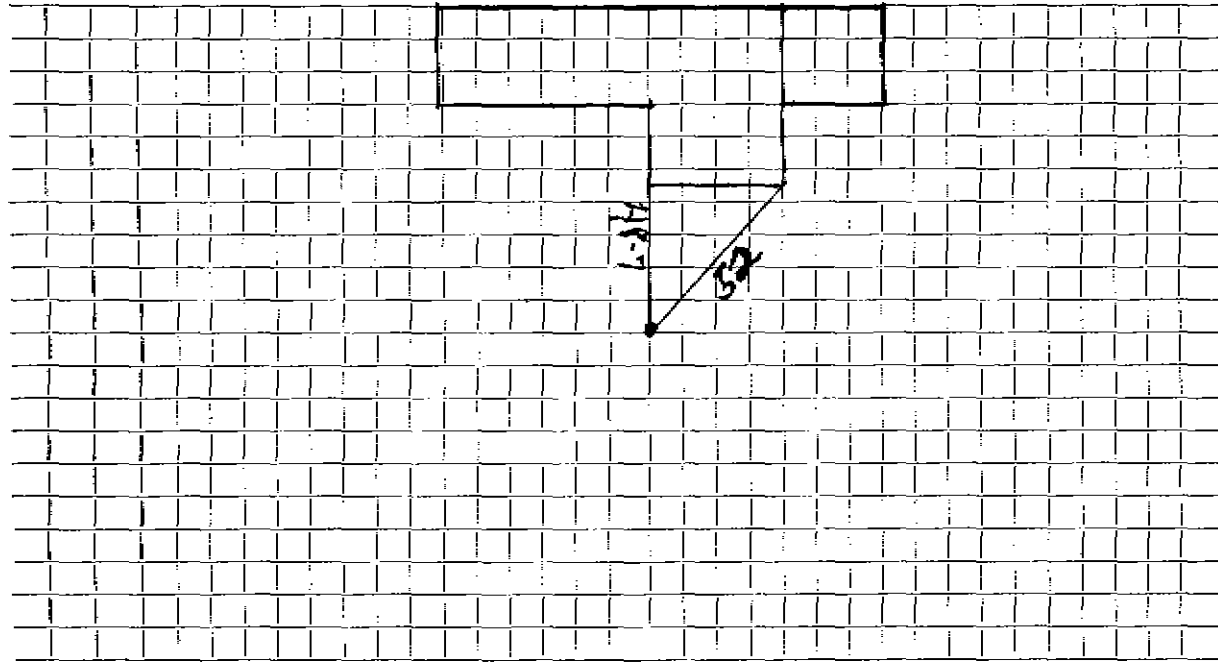

Connection made in Street. Work completed

Remarks:
.....
.....