

WATER SERVICE RECORD

Name DeVries Const. Co.

Service No. 140

Address 15 Bryant Road

#17461

Location

Repair ~~Renewal~~ - New Service

Comm 8-22-60


Date	Material	Amount	Total	Date	Material	Amount
10-1-59	Labor	1 85		7-21-60	Deposit	30 00
	10% O. H.	19	2 04	8-22-60	Paid by SP# 141	1 23
	Owner's copper					31 23
	8' out				<u>NON CHARGE</u>	
7-28-60	Labor	1 94		10-1-59	Labor	1 85
	10% O. H.	19	2 13		1 3/4" C Corp Cock	4 64
	44' 3/4" galv. tubing	42	18 48		1 3/4" C Curb Cock	5 94
	1 3/4" Ext. L.W.F. Stop Valve	6 17			1 Box & Rod	5 00
	1 3/4" CS neck Union	2 41	2 41			17 43
			31 23		1 1/2" Straight tailpiece	50
					1 1/2" Offset tailpiece	50
						18 43

DATE \_\_\_\_\_

TOWN OF LEXINGTON — BOARD OF PUBLIC WORKS

**WATER DIVISION**

Sketch of Service Here

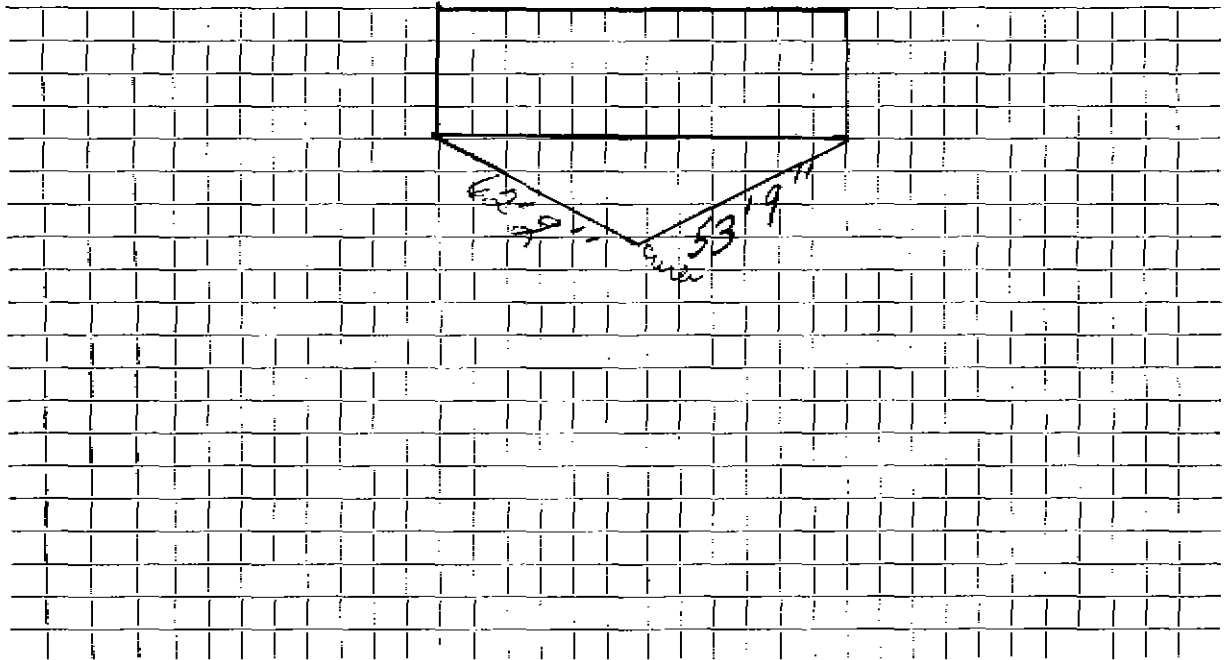

Connection made in ..... Street. Work completed .....

Remarks: .....  
.....  
.....