

## WATER SERVICE RECORD

Name DeVries Const. Co.

Service No. 141

Address 16 Bryant Road

#7550

Location

~~Repair~~ ~~Renewal~~ New Service

Comm 8-22-60


Date	Material	Amount	Total	Date	Amount
10-1-59	Labor	1 85		7-21-60	30 00
	10% O. H.	19	2 04	8-22-60	4 17
	Owner's copper 25' out				34 17
					<u>NON CHARGE</u>
7-22-60	Labor	1 84		10-1-59	1 85
	10% O.H.	19	2 13	1	3/4" C Corp Cock
	31' 3/4" copper tubing	42	21 42	1	3/4" C Curb Cock
	1 3/4" exl I. B. stock waste		6 17	1	Box & Rod
	2 3/4" 85 part Trigon		2 41		17 43
			34 17	1	1/2 Straight tailpiece
				1	1/2 Offset tailpiece
					18 43

DATE \_\_\_\_\_

TOWN OF LEXINGTON — BOARD OF PUBLIC WORKS

**WATER DIVISION**

Sketch of Service Here

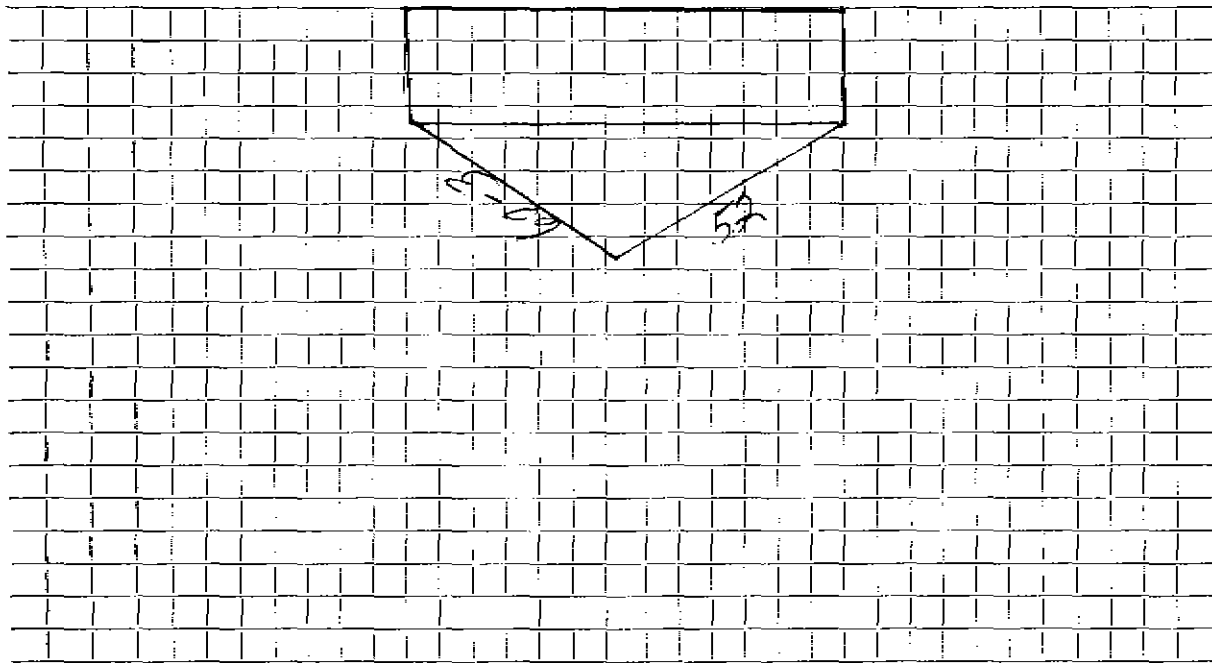

Connection made in ..... Street. Work completed .....

Remarks: .....

.....

.....