

WATER SERVICE RECORD

5162

Name DeVries Const. Co.

Service No. 142

Address 18 Bryant Road

Location

~~Repair Renewal~~ New Service

Comm 8-22-60


Date	Material	Amount	Total	Date	Amount		
10-1-59	Labor	1 85		9-21-60	Deposit	30 00	
	10% O. H.	19	2 04	8-22-60	Paid by S.M.A. 14.3	3 75	
	Owner's copper					33 75	
	24' out				<u>NON CHARGE</u>		
7-22-60	Labor	1 94		10-1-59	Labor	1 85	
	10% O.H.	19	2 13	1	3/4" C Corp Cock	4 64	
50'	3/4" Copper tubing @ .42		21 00	1	3/4" C Curb Cock	5 94	
1	3/4" Cx 1/2 I.W.H. Stop & Waste		6 17	1	Box & Rod	5 00	
1	3/4" c3 Part Union		2 41			17 43	
			33 75	7-22-60	1	1/2 Straight tailpiece	50
					1	1/2 Offset tailpiece	50
						18 43	

DATE _____

TOWN OF LEXINGTON — BOARD OF PUBLIC WORKS

WATER DIVISION

Sketch of Service Here

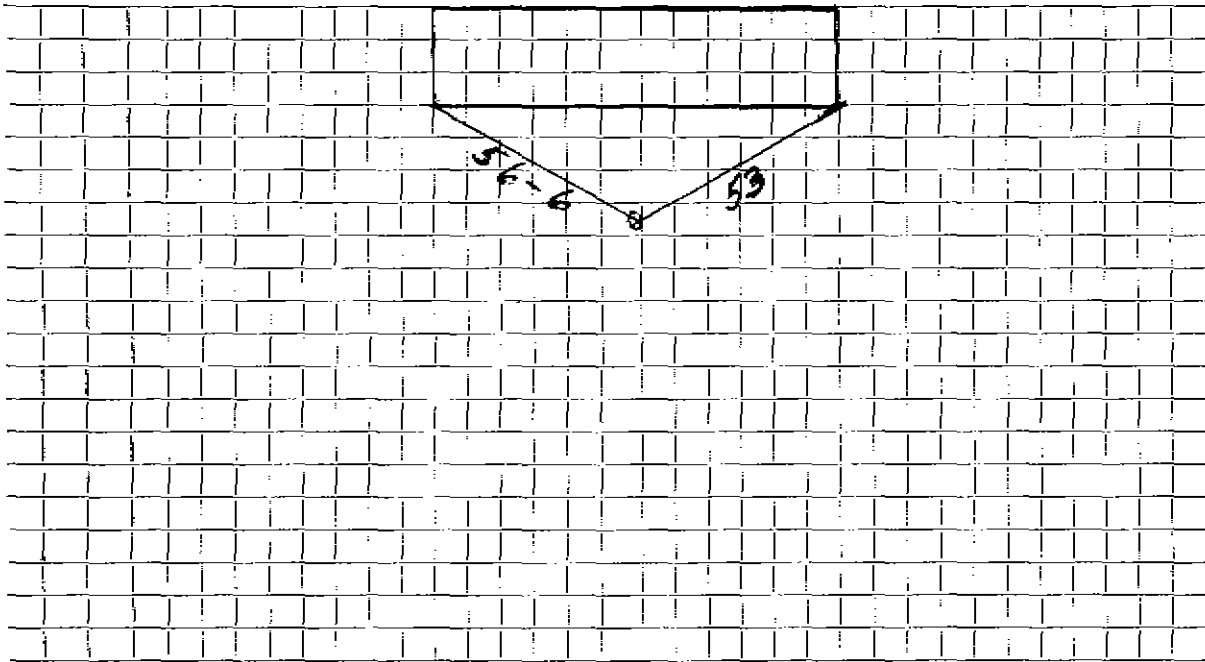

Connection made in Street. Work completed

Remarks:

.....
.....