

WATER SERVICE RECORD

Name West Chester Estates, Inc.

Service No. 103

Address 19 Bryant Road

#6962

Location

~~Repair - Renewal~~ New Service*Contract # 103*


Date	Material	Amount	Total	Date	Material	Amount
9-30-59	Labor	1 85		9-30-59	Digout	30 00
	10% O. H.	19	2 04	9-30-59	Rehaul	2 33
	Owner's copper					27 67
	6' out				<u>NON CHARGE</u>	
9-23-60	Labor	1.75		9-30-59	Labor	1 85
	10' O.H.	.18	1.93		1 3/4" C Corp Cock	4 64
	36' 3/4" Copper tubing @ .42		15.12		1 3/4" C Curb Cock	5 94
	1 3/4" C 3 part union		2.41		1 Box & Rod	5 00
	1 3/4" C x 1 I.W.T. Stop & Waste		6.17			17 43
			27.67		1 1/2" Straight tailpiece	.50
					1 1/2" Offset tailpiece	.50
						18.43

A. J. Jones Co. (19)

DATE _____

TOWN OF LEXINGTON — BOARD OF PUBLIC WORKS
WATER DIVISION

Sketch of Service Here

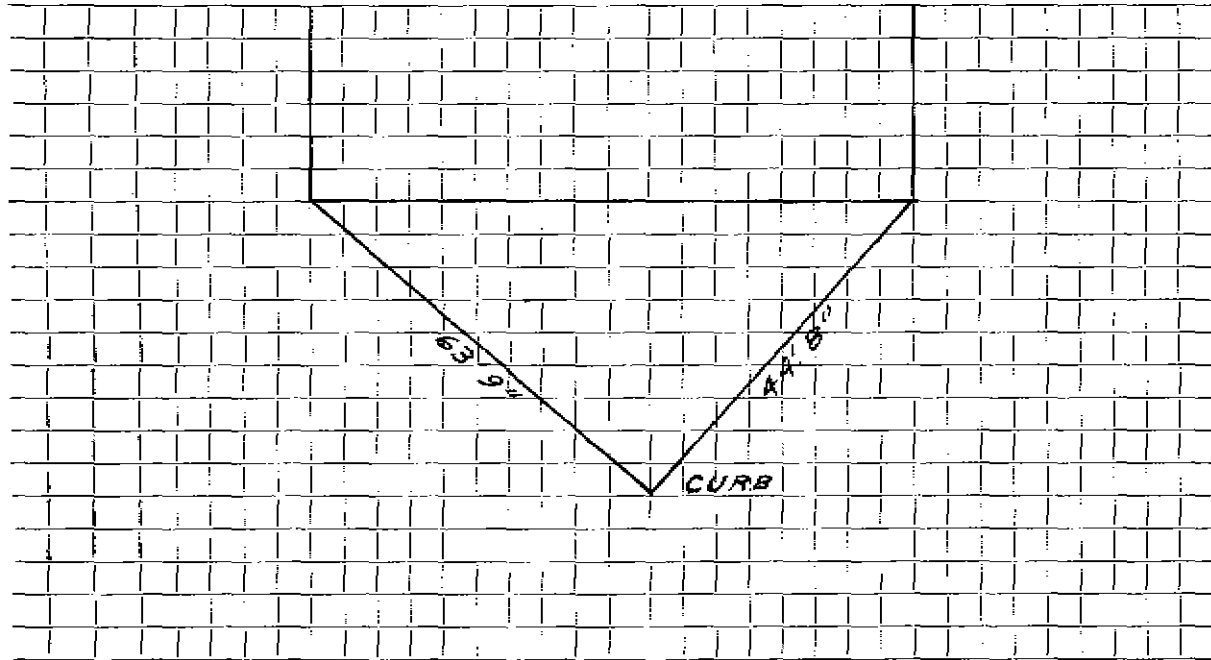

Connection made in Street. Work completed

Remarks:

.....
.....