

WATER SERVICE RECORD

Name DeVries Const. Co.

Service No. 143

Address 20 Bryant Road

1917

Location

~~Repair~~ ~~Renewal~~ New Service

Comm 5-22-60


Date	Material	Amount	Total	Date	Material	Amount
9-30-59	Labor	1 85		7-21-60	Deposit	30 00
	10% O. H.	19	2 04	8-22-60	Paid by SHO # 144	5 43
	Owner's copper					35 43
	23' out				<u>NON CHARGE</u>	
7-22-60	Labor	1 94		9-30-59	Labor	1 85
	10% O.H.	19	2 13	1	3/4" C Corp Cock	4 64
54'	3/4" Copper tubing @ .42		22 68	1	3/4" C Curb Cock	5 94
1	3/4" Cx I.V.E. Stop & Waste		5 17	1	Box & Rod	5 00
1	3/4" C3 Part Union		2 41			17 43
			35 43	7-22-60	1 1/2 Straight tailpiece	50
					1 1/2 Offset tailpiece	50
						18 43

DATE _____

TOWN OF LEXINGTON — BOARD OF PUBLIC WORKS

WATER DIVISION

Sketch of Service Here

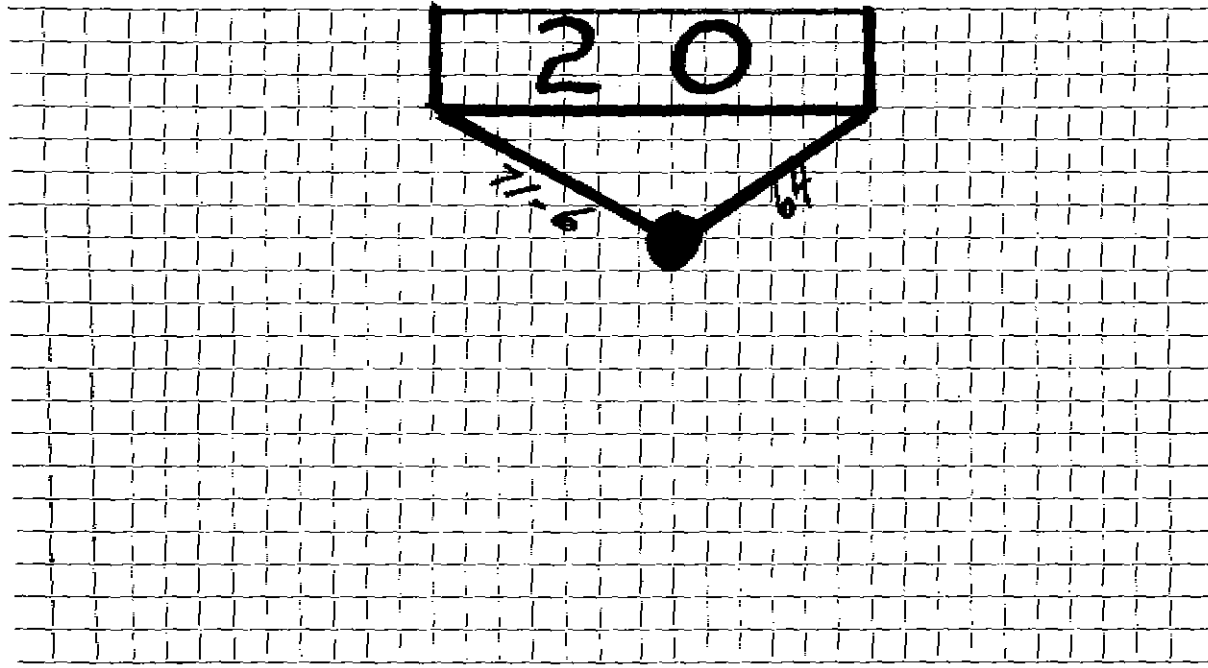

Connection made in Street. Work completed

Remarks:
.....
.....