

WATER SERVICE RECORD

Name West Chester Estates Inc.

Service No. 199

Address 21 Bryant Road

Location

~~Repair~~ ~~Renewal~~ New Service

Plan 10-25-50


Date	Material	Amount	Total	Date	Material	Amount
9-30-59	Labor	1 85		9-30-59	Deposit	.30 00
	10% O. H.	19	2 04	10-24-60	Paid by WCHET 199	19
	Owner's copper					30 19
	10' out				<u>NON CHARGE</u>	
9-23-60	Labor	1.75	1.75	9-30-59	Labor	1 85
	10% O.H.	.18	1.93	1	3/4" C Corp Cock	4 64
12'	3/4" Copper tubing @.42		17.64	1	3/4" C Curb Cock	5 94
1	3/4" C x 1/2" I.W.H. Stop & Waste		6.17	1	Box & Rod	5 00
1	3/4" C 3 part union		2.41			17 43
			30.19	1	1/2" Straight tailpiece	.50
				1	1/2" Offset tailpiece	.50
						18.43

DATE _____

TOWN OF LEXINGTON — BOARD OF PUBLIC WORKS

WATER DIVISION

Sketch of Service Here

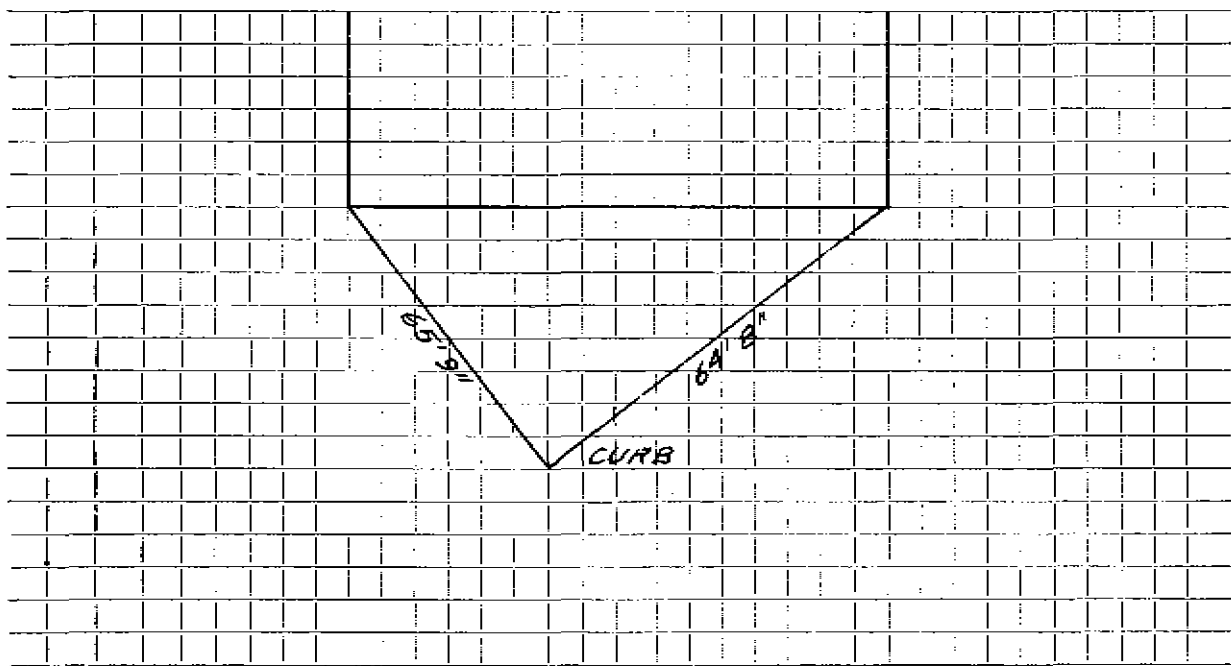

Connection made in Street. Work completed

Remarks:
.....
.....