

WATER SERVICE RECORD

Name DeVries Const. Co.

Service No. 144

Address 22 Bryant Road

Location

~~Repair~~ ~~Renewal~~ New Service

Comm 5-22-60


Date	Material	Amount	Total	Date	Amount	
9-30-59	Labor	1 85		7-21-60	30 00	
	10% O. H.	19	2 04	8-22-60	7 17	
	Owner's copper 23' out				37 17	
					<u>NON CHARGE</u>	
7-22-60	Labor	1 94		9-30-59	Labor	1 85
	10% O.H.	19	2 13	1	3/4" C Corp Cock	4 64
51'	3/4" Copper tubing@.42		21 42	1	3/4" C Curb Cock	5 94
1	3/4" Cx 1/2 I.W.M. Stop Waste		6 17	1	Box & Rod	5 00
1	Hr. trucking@3.00		3 00			17 43
1	3/4" C3 Part Union		2 41	7-22-60	1 3/8 Straight tailpiece	50
			37 17	1	3/8 Offset tailpiece	50
						18 43

DATE _____

TOWN OF LEXINGTON — BOARD OF PUBLIC WORKS

WATER DIVISION

Sketch of Service Here

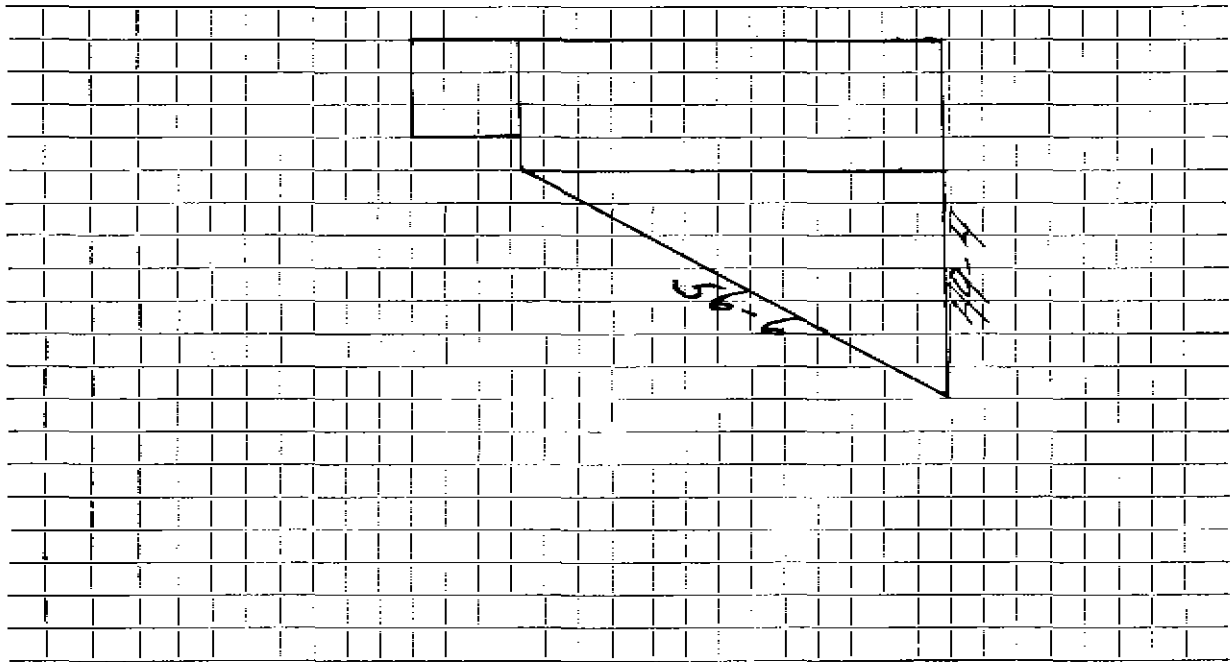

Connection made in Street. Work completed

Remarks:
.....
.....