

WATER SERVICE RECORD

#5590

Name DeVries Const. Co.

Service No. 37

Address 3 Bryant Road

Location

~~Repair~~ ~~Renewal~~ New Service


Conn 5-16-60

Date	Material	Amount	Total	Date	Amount	
4-20-60	Labor	1 94		4-14-60	Deposit	20 00
	10% O.H.	19	2 13			
	60' 3/4" Copper Tubing @42		25 20			
	1 3/4" Cx 1/2" IWH Stop&Waste		6 17		<u>NON CHARGE</u>	
	1 3/4" G3 Part Union		2 11	1 1/2"	Straight tailpiece	50
			35 91	1 1/2"	Offset tailpiece	50
						1 00

TOWN OF LEXINGTON — BOARD OF PUBLIC WORKS

WATER DIVISION

Sketch of Service Here

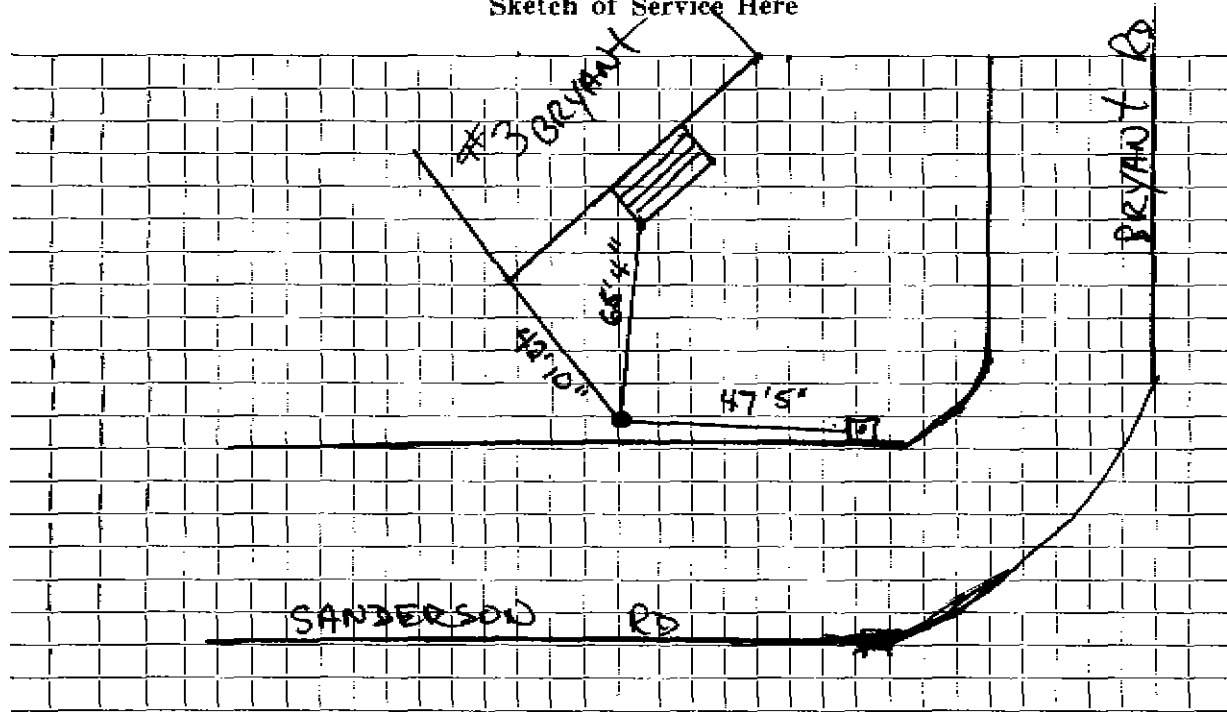

Connection made in Street. Work completed

Remarks:

.....

.....