

WATER SERVICE RECORD

# 5646

Name DeVries Const. Co.

Service No. 38

Address 4 Bryant Road

Location Lot #3

REMARKS ~~General~~ - New Service

Comm 7-5-68


Date	Material	Amount	Total	Date		Amount
5-5-60	Labor 3.82			4-14-60	Deposit	20 00
	10 % O.H. .38		4 20	7-5-60	Paid by SHP # 78	6 43
	54' 3/4" Copper tubing @ .42	22 68		7-25-60	Paid	9 23
	1 3/4" Cx 1/2 I.W.H. Stop & Waste	6 17				35 44
	1 3/4" G3 Part Union		2 41		NON CHARGE	
			35 46			
				1	1/2" Straight tailpiece	50
				1	1/2" Offset tailpiece	50
						1 00

DATE \_\_\_\_\_

TOWN OF LEXINGTON — BOARD OF PUBLIC WORKS

**WATER DIVISION**

Sketch of Service Here

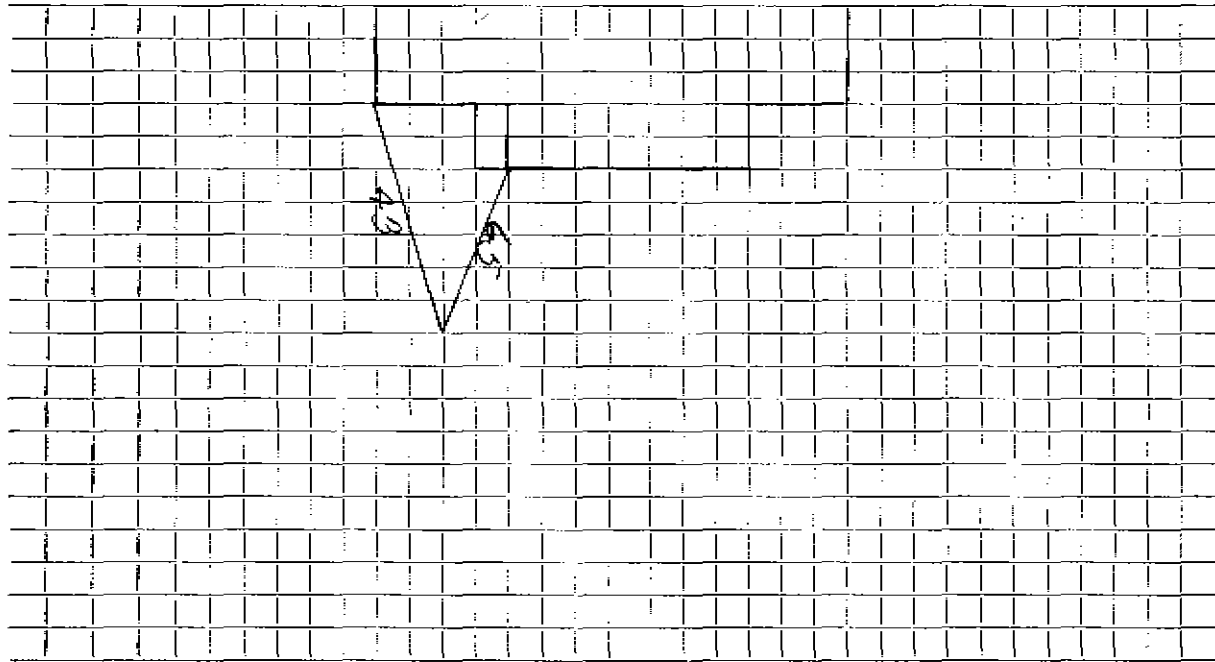

Connection made in ..... Street.      Work completed .....

Remarks: .....  
.....  
.....