


DATE September 2016

TOWN OF LEXINGTON — BOARD OF PUBLIC WORKS

WATER DIVISION

Sketch of Service Here

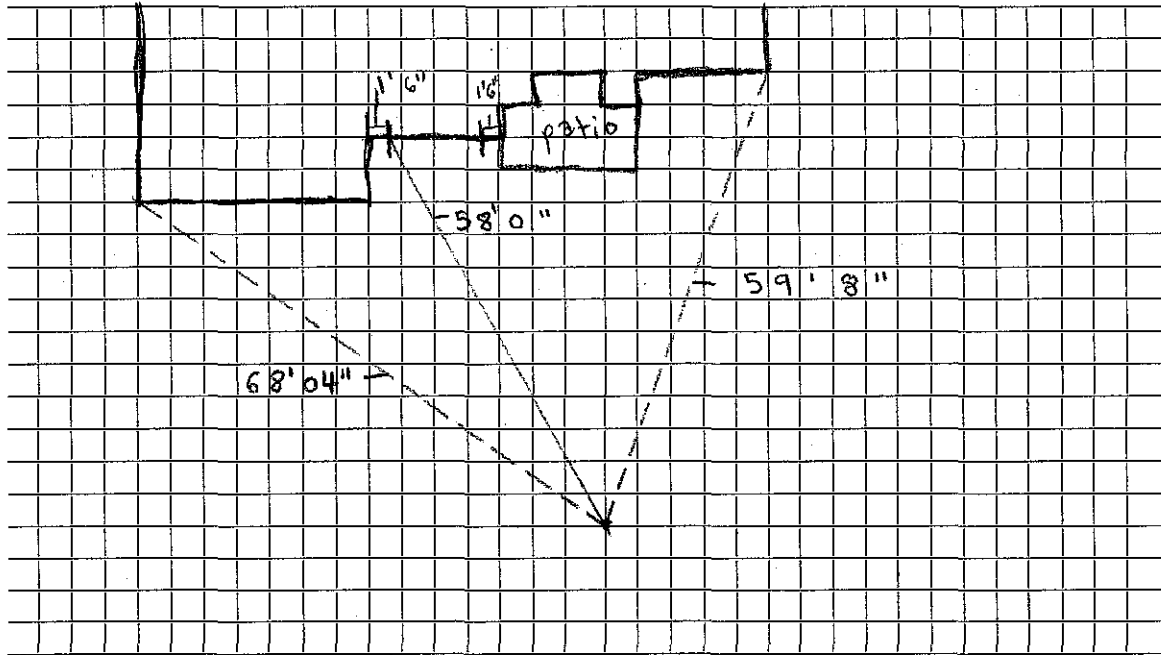

Connection made in 7 Bryant Road Street. Work completed

Remarks: