

WATER SERVICE RECORD

3281

Name West Chester Est. Inc.

Service No. 135

Address 8 Bryant Road

Location

~~Repair~~ ~~Renewal~~ New Service

*Comm 8-22-60*


Date	Material	Amount	Total	Date	Amount
10-3-59	Labor	1 85		7-19-60	Deposit
	10% O. H.	19	2 04	8-22-60	Paid by 51124-135
	Owner's copper				34 87
	24' out				<u>NON CHARGE</u>
7-22-60	Labor	2 95		10-3-59	Labor
	10% O.H.	30	3 25	1	3/4" C Corp Cock
50'	3/4" Copper tubing @ .42		21 00	1	3/4" C Curb Cock
1	3/4" Cx 1/2 I.W.H. Stop & Waste		6 17	1	Box & Rod
1	3/4" C3 Part Union		2 41		17 43
			34 87	7-22-60	1 1/2 Straight tailpiece
					1 1/2 Offset tailpiece
					18 43

DATE \_\_\_\_\_

TOWN OF LEXINGTON — BOARD OF PUBLIC WORKS

**WATER DIVISION**

Sketch of Service Here

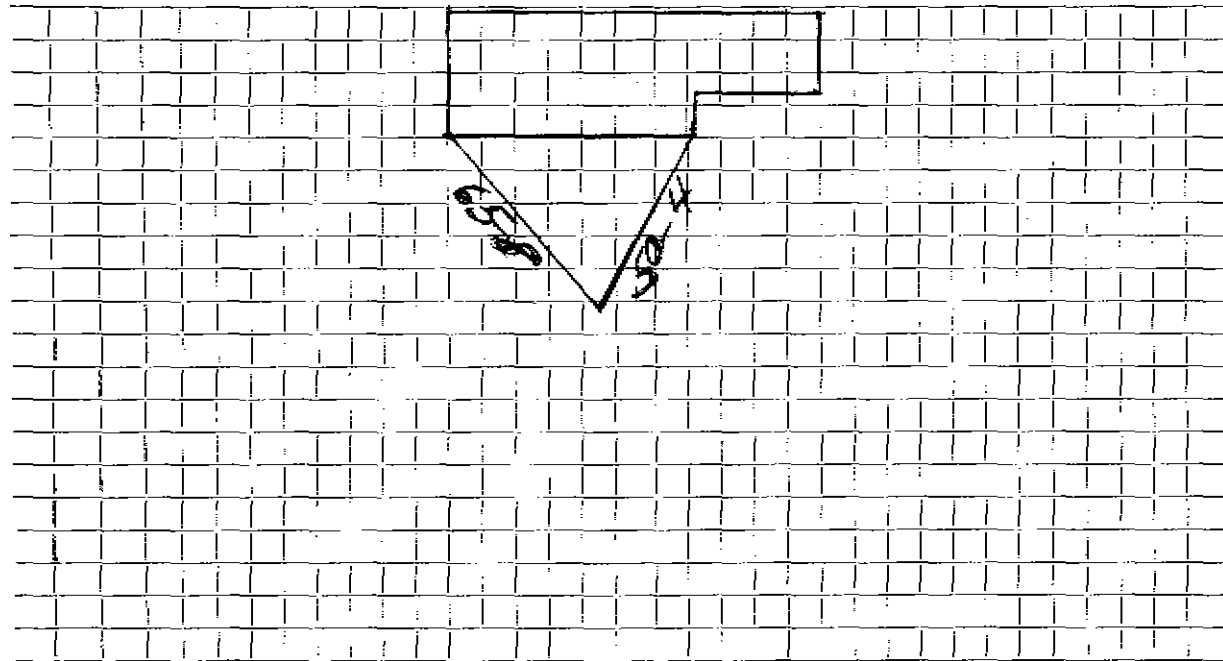

Connection made in ..... Street.      Work completed .....

Remarks: .....

.....

.....